

KANSAS


FORM 51 5M 6-46 PETROL

Elk County

Section 27 Township 29 Range 8E

Well No. #1 Fagerberg "B"

Company K. T. Weidemann

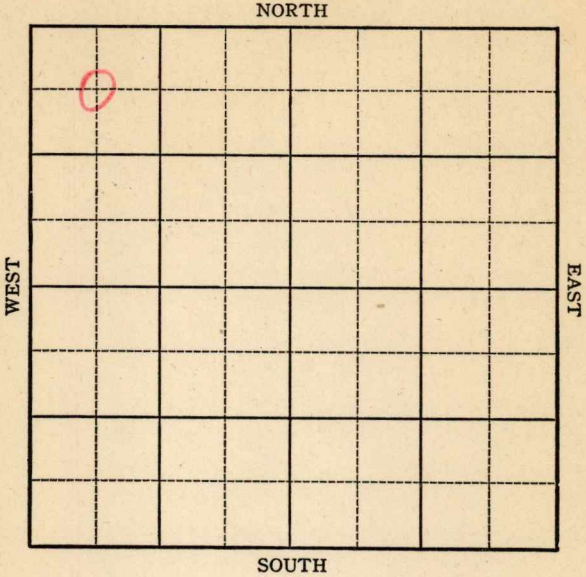

Sec. 27 Twp. 29 R. 8E

Well No. #1 Fagerberg "B" Farm  
K. T. Weidemann Company


Miscellaneous

660 Ft. from N. Line

\_\_\_\_\_ Ft. from S. Line

\_\_\_\_\_ Ft. from E. Line

660 Ft. from W. Line

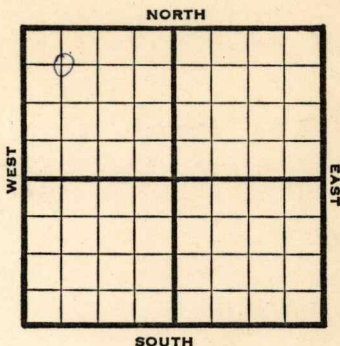

C NW NW

REPORT

1946

7/17	10" @ 20 1708'
7/23	KC 2003 Drlg 2405'
7/30	<b>Miss 2803-15 TD</b> 7" @ 2803, RUST
8/6	" "
8/13	Drlg 2839'
8/20	TD 2851'
8/27	"
9/5	"
9/10	"
9/18	"
9/24	"
10/1	"
10/8	"
10/15	"
10/22	"
10/29	"
11/6	"
11/12	"
11/20	"
11/27	"
12/3	"
12/10	"
12/17	"

OVER

1947

1/4 TD 2851'

1/8 "

1/15 "

1/21 "

2/12 Miss 2803'

7" @ 2803

TD 2851'

**ABANDONED**

INSAS

Kansas Pool Name Miscellaneous

Map No. 10 Sec. 27 Twp. 29 R. 8E

Well No. 1 Fagerberg "B"

K. T. Weidemann Company

**FIRST REPORT**

Contractor

C NW NW

SECTION PLAT

660 Ft. from N. Line

\_\_\_\_\_ Ft. from S. Line

\_\_\_\_\_ Ft. from E. Line

660 Ft. from W. Line

o			

~~Elk County~~

ELK

Location \_\_\_\_\_

Rig up \_\_\_\_\_

Drilling and Remarks:

10" @ 20'

1708'

RECORD

Cased \_\_\_\_\_ in., \_\_\_\_\_ ft.

Sand \_\_\_\_\_

Gas \_\_\_\_\_

Oil \_\_\_\_\_

Total Depth \_\_\_\_\_

PRODUCTION

1st 24 hrs. Nat. \_\_\_\_\_

1st 24 hrs. after shot \_\_\_\_\_

Gas \_\_\_\_\_ Cu. Ft.

Dry Hole \_\_\_\_\_

Abandoned \_\_\_\_\_

Date

JUL 17 1946 19

S. J. LEWIS

Scout

**KANSAS**

Map No. 10 Sec. 27 Twp. 29 R. 8E

Well No. 1 Fagerberg "B"

K. T. Weidemann Company

**ABANDONED** Contractor

C NW NW

**SECTION PLAT**

660 Ft. from N. Line

\_\_\_\_\_ Ft. from S. Line

\_\_\_\_\_ Ft. from E. Line

660 Ft. from W. Line

o			

Elk County

Location \_\_\_\_\_

Rig up \_\_\_\_\_

Drilling and Remarks:

*Miss 2803  
7" 02803*

**RECORD**

Cased \_\_\_\_\_ in., \_\_\_\_\_ ft.

Sand \_\_\_\_\_

Gas \_\_\_\_\_

Oil \_\_\_\_\_

Total Depth 2851

**PRODUCTION**

1st 24 hrs. Nat. \_\_\_\_\_

1st 24 hrs. after shot \_\_\_\_\_

Gas \_\_\_\_\_ Cu. Ft.

Dry Hole \_\_\_\_\_

Abandoned \_\_\_\_\_

Date

FEB 1 2 1947 19

S. J. LEWIS Scout