

Russell


FORM 51

KANSAS

Section 21 Township 14 Range 13N

Well No. #6 Graham "B"

Company Jayhawk Well Servicing

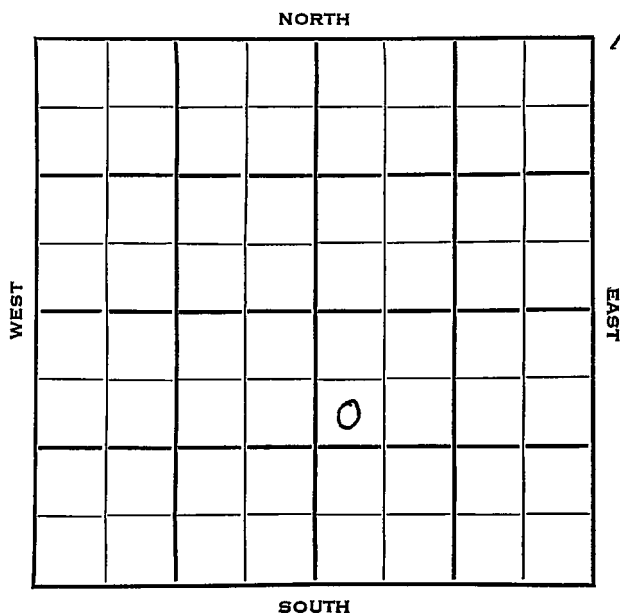

Russell **KANSAS**

SEC.	TWP	R.
21	14	13 W

WELL NO.

6 Graham "B" FARM

COMPANY

Jayhawk Well Servicing

CONTRACTOR

Hall-Burney Pool


990 Ft. from N. Line

Ft. from S. Line

Ft. from E. Line

330 Ft. from W. Line

SW NW SE

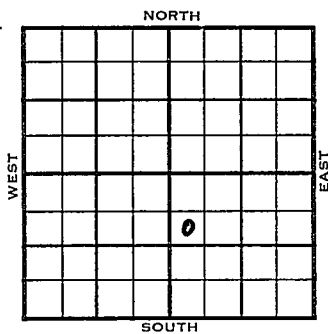

	ELEVATION	REPORT
1953	1771'	
9/23	RUCT	
9/30	13" @ 315'	
	4" @ 480'	
	Drlg 515'	
10/7	Anhy 750' 8" @ 715'	
	Drlg. 1620'	
10/14	Tarkio 2291'	
	7 goph	
	TD 2335'	
	5" @ 2335'	
10/21	Spud 9-25-53	
	Oil Well	
	TD 2335'	
	13" @ 315'	
	10" @ 480'	
	Anhy 750'	
	8" @ 715'	
	Tarkio 2291'	
	7 goph	
	TD 2335'	
	5" @ 2335'	
	CO to 2330'	
	23/2310-14	
	sd-oil-ffac	
	S/5 boph	
	Comp. 25 bopd	COMPLETED

County Russell State Kansas

Sec. 21 (Blk. Twp.) 14 (Sur. Rge.) 13W Map No.

Operator Jayhawk Well Servicing

Well No. 6 Farm Graham "B"

Elev.	Location	SW NW SE
-------	----------	----------

FIRST REPORT

990 Ft. From N Line SE

330 Ft. From W Line Quarter

1st. Report SEP 23 1953

Completion


Remarks

Spudding Date

Drig. Data Hall-Gurney Pool

RICT.

County Russell State Kansas
 Sec. 21 (Blk.) 14 (Sur.) 13W Map No.
 Operator Jayhawk Well Servicing
 Well No. 6 Farm Graham "B"
 Elev. 1771 Location SW NW SE

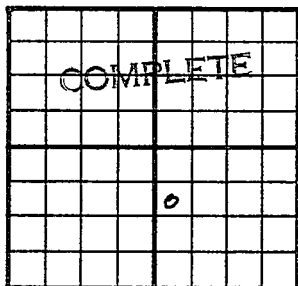

990 Ft. From N Line SE
330 Ft. From W Line Quarter
 1st. Report
 Completion OCT 21 1953
 Remarks Hall-Gurney Pool
 Spudding Date 9-25-53

Drlg. Data Oil well TD 2335
13" @ 315 10" @ 480 Anhy 750 8" @ 715
Tarkio 2291 7 goph TD 2335 5" @ 2335
CO to 2330 23/ 2310-14 sd-oil-frac
S/ 5 boph Comp. 25 bopd

J. G. McGEHEE