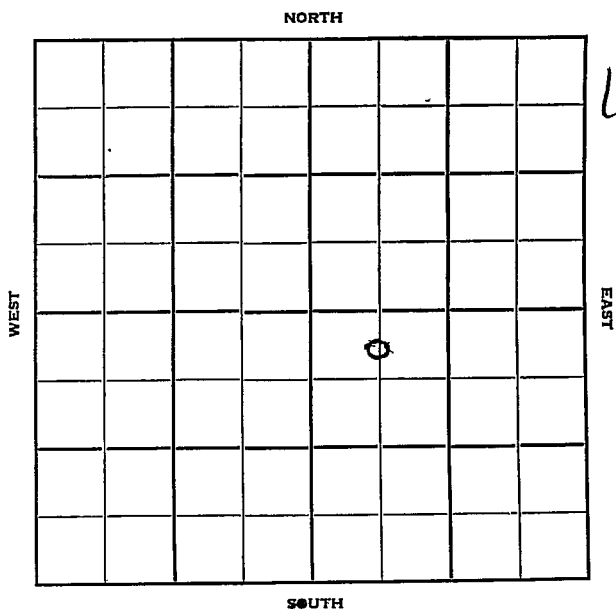


Section 2 Township 16 Range 14WWell No. #6 Batt (B)Company Shell Oil

Barton KANSAS

Sec. 2 Twp. 16 R. 14 W

Well No. # 6 Batt (B) Farm

Shell Oil Company

Peel Contractor


330 Trapp
Ft. from N. Line

..... Ft. from S. Line

..... Ft. from E. Line

660 Ft. from W. Line

C N/2 NW SE

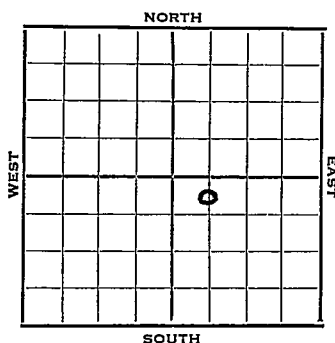

1952 Elev. 1863' REPORT

6/25 Location

7/2 8" @630

7/9 Drlg. 2625'
Tarkio 2502 Topeka 2775
Lans. KC 3087 Cong 3303
RTD 3366 Schl 4" @ 3350

7/17 CO 3316 40/3293-3303
B/14 gals & 13 galwph for 10 hrs.
2000 A S/40 BO & 8 BW 16 hrs.
P/60 BO 12 hrs.

7/23 Spud 6-25-52 Oil Well TD 3366
8" @ 630 Tarkio 2502 Top 2775
Lans. 3087 Cong. 3303
TD 3366 4" @ 3350 CO to 3316
40/3293-3303 B/14 go 13 gwph
2000 A S/40 bo 8 bw 16 hr.
P/60 bo 12 hr. Comp. 26 bopd 1 bw


J. G. McGEHEE

County Barton State Kansas
 Sec. 2 (Blk.) 16 (Sur.) 14W Map No.

Operator Shell Oil

Well No. 6 Farm Batt "B"

Elev. 1863 Location C N L NW SE

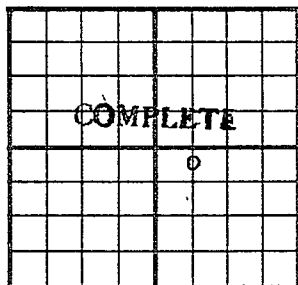

330 Ft. From N Line SE

660 Ft. From W Line Quarter

1st. Report

Completion JUL 23 1952

Remarks Trapp Pool

Peel - Contr.

Spudding Date 6-25-52

Drlg. Data Oil well TD 3366

8" @ 630 Tarkio 2502 Top. 2775

Lans. 3087 Cong. 3303 TD 3366

4" @ 3350 CO to 3316 40/ 3293-3303

B/ 14 go 13 gwph 2000 A

S/ 40 bo 8 bw 16 hr. P/ 60 bo 12 hr.

Comp. 26 bopd 1 bw

J. G. McGEHEE