


Section 21 Township 14 Range 19W

Well No. #1 Rogg

Company Eldorado Refg.

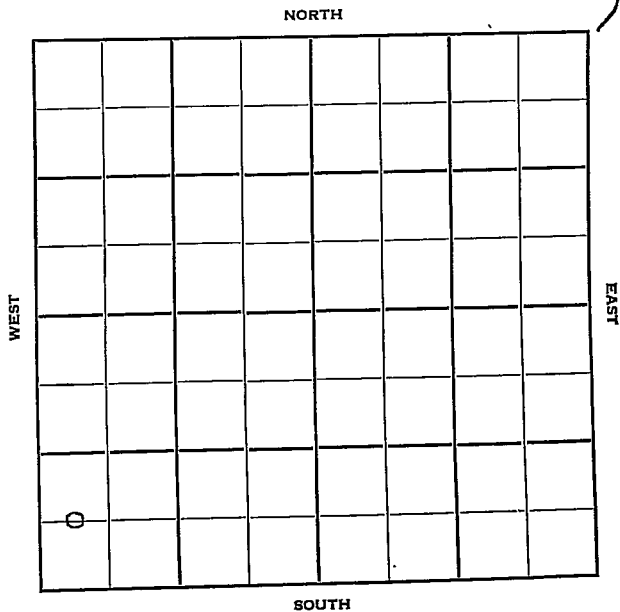

Russell

~~KAYONS~~

Sec. 21 Twp. 14 R. 13W

Well No. #1 Rogg Farm

El Dorado Ref. Company

Murfin Drlg. Contractor

Hall-Gurney Pool


_____ Ft. from N. Line

660' Ft. from S. Line

_____ Ft. from E. Line

330' Ft. from W. Line

C W L SW SW

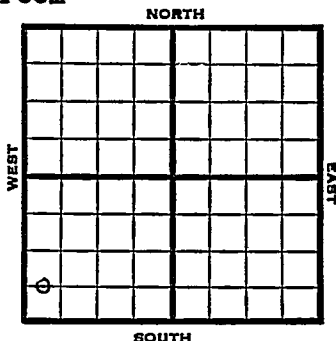

1951 Elev. 1763' REPORT

8/22 Cellar & Pits
 10/24 Spud 9-9-51
 Oil Well TD 2350
 8" @ 718'
 Anhy 712 Tarkio 2305-50
 7" @ 2350 TD 2350
 48/ 2305-10
 Hydro.
 S/ 11 BOPH 8 hr.
 Comp. 35 BOPD

COMPLETED

County Russell State Kansas

Sec. 21 (Blk. 14) (Sur. 13W) (Twp.) (Rge.) Map No.

Operator Eldorado Ref.

Well No. 1 Farm Rogg

Elev. _____ Location C W L SW SW

FIRST REPORT

660 Ft. From S Line SW

330 Ft. From W Line Quarter

1st. Report AUG 22 1951

Completion

Remarks

Spudding Date

Drlg. Data Hall-Gurney Pool

Cellar & pits

County Russell State Kansas

Sec. 21 (Blk. Twp.) 14 (Sur. Rge.) 13W Map No.

Operator Eldorado Ref.

Well No. 1 Farm Rogg

Elev. 1763 Location C W L SW SW

COMPLETE

660 Ft. From S Line SW

330 Ft. From W Line Quarter

Ist. Report

Completion OCT 24 1951

Remarks Hall-Gurney Pool

Murfin Drlg. - Contr.

Spudding Date 9-9-51

Drlg. Data Oil well TD 2350

8" @ 718 Anhy 712 Tarkio 2305-50

7" @ 2350 TD 2350 48/ 2305-10 Hydro.

S/ 11 boph 8 hr. Comp. 35 bopd