


Section 28 Township 29 Range 8E

Well No. 1 Hoard

Company K. T. Weidemann

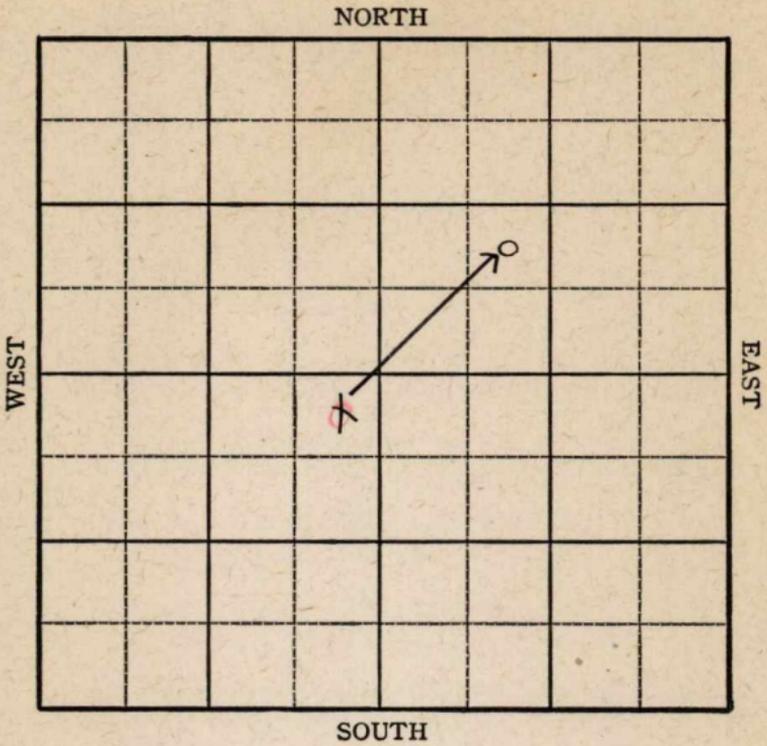

KANSAS

Sec. 28 Twp. 29 R. 8-E

Well No. #1 Hoard Farm


K.T. Weidemann Company

~~330~~ Ft. from N. Line

990 Ft. from S. Line

~~330~~ Ft. from E. Line

990 Ft. from W. Line

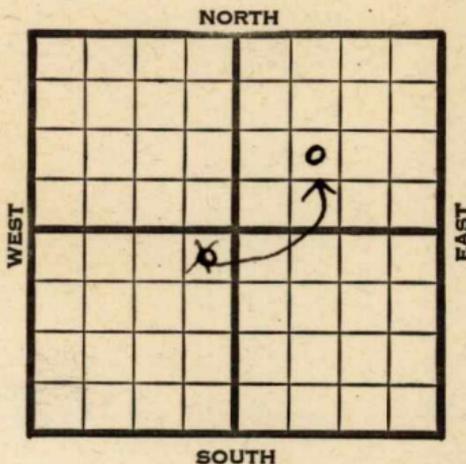

NE SW NE

1945

REPORT

8/15 Rotary

8/22 10" @ 21
Drlg. 400'

8/29 Drlg. 1980

9/5 " "

9/12 **Miss. 2808**

TD 2812

5" @ 2812 RUST

9/19 TD 2844

1000 acid.

Pump 25 oil SW a day

9/26 **Miss. 2808**

5" @ 2812

1000 acid.

TD 2844

Pump 25 Pot.

Grav. 37.0

COMPLETED

Pool Name Miscellaneous

KANSAS

Map No. 10 Sec. 28 Twp. 29 R. 8E

Well No. 1 Hoard


K. T. Weidemann Company

FIRST REPORT Contractor

NE SW

SECTION PLAT

330 Ft. from N. Line
 Ft. from S. Line
330 Ft. from E. Line
 Ft. from W. Line

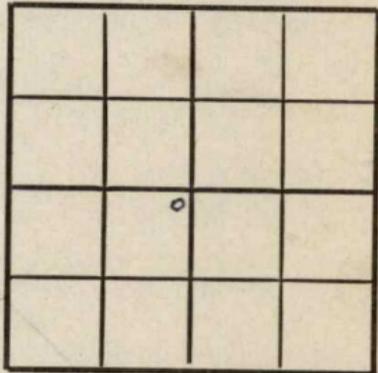

Butler County

RECORD

Location _____
Rig up _____
Drilling and Remarks:
rotary

Cased _____ in., _____ ft.
Sand _____
Gas _____
Oil _____
Total Depth _____

PRODUCTION

1st 24 hrs. Nat. _____
1st 24 hrs. after shot _____
Gas _____ Cu. Ft.
Dry Hole _____
Abandoned _____

Date

AUG 15 1945

19

S. J. LEWIS

Scout

