


Section 2 Township 16 Range 14W

Well No. #8 Schneider "C"

Company Shell Oil

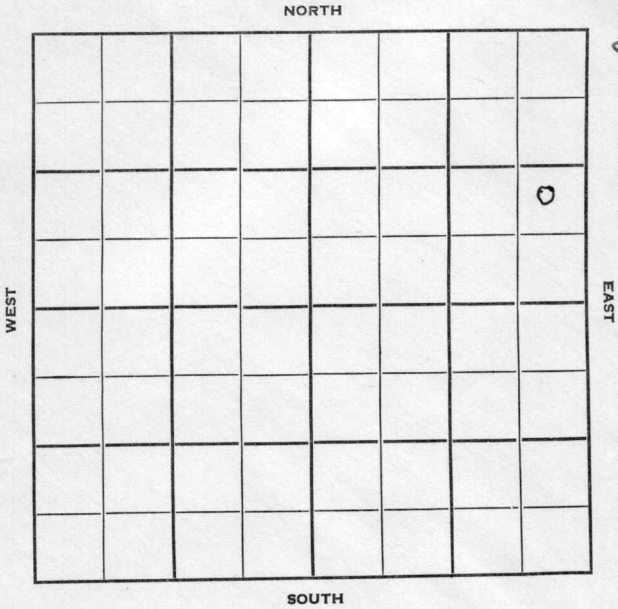

Barton

KANSAS

Sec. 2 Twp. 16 R. 14W

Well No. #8 Schneider "C" Farm

Shell Oil Company

K & E Drlg. Contractor


Ft. from N. Line

1090' Ft. from S. Line

330 Ft. from E. Line

Ft. from W. Line

NE $\frac{1}{4}$ NE SE NE

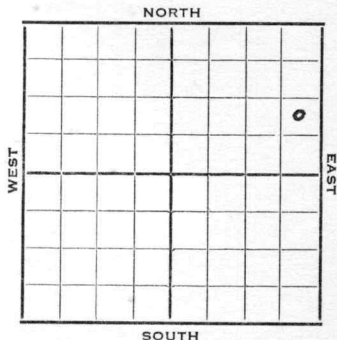

1952 Elev. 1866' REPORT

- 10/22 Spud 10-16-52
10" @ 629'
Drlg. 1677'
- 10/29 Tarkio 2489' Topeka 2761'
Drlg. 3034'
- 11/5 Lans KC 3072 Arb. 3284
RTD 3353 Schl. 7" @ 3352
CO 3313 40/ 3284-94 S/ 24 BO &
20 BW 6 hrs.
- 11/12 P/30 Bo & 140 BW 14 hrs.
- 11/20 P/53 BO plus 153 BWPD
- 11/27 NR
- 12/4 "
- 12/11 "
- 12/18 NR
- 12/25 NR
- 1/1 NR
- 1/8 NR
- 1/22 NR

OVER

#8 Schneider "C"

1953
1/28

Spud 10-16-52

Oil Well

T. 3353

10" @ 629

Tarkio 2489, Top 2761, Lans
3072, Arb. 3284

TD 3353

7" @ 3352

CO to 3313

40/3284-94, S/24 bo 20 bw
6 hrs.

S/25 bo 47 bw 7 hrs.

P/30 bo 140 bw 17 hrs.

P/53 bo 153 bwph

Comp. 37 bopd 171 bw

COMPLETED

O.W.W.O.

FORM 513 SUNRAY

County Barton Elev. 1866
 Sec. 2 Twp. 36 Rge. 1/W
 Company Shell Oil
 Farm Name Schneider "C" No. 8

TOPS	DEPTH	LOG	DATUM	Loc. in Sec.
Anh.				NE SE NE
Tp.				1090' SL
H.				<u>O.W.W.O.</u>
Tr.				Geol. <u>O.W.W.O.</u>
Dg.				Contr.
Bl.				
L.		307 1/4		
K.C.				
B.K.C.				
Ce.				
C.				
M.				
M.				Pool
K.				Trapp
Mz.				<div style="border: 1px dashed black; padding: 5px; display: inline-block;"> <p style="margin: 0;">FIRST REPORT</p> <hr style="width: 50%; margin: 5px auto;"/> <p style="margin: 0;">COMPLETE</p> </div>
Me.				
V.				
S.				
S.				
A.		328 1/4		
R.				
PE.				
G.				
T.D.				FEB 13 '57

Date Comm. OTD 3353 7" @ 3352 PB 3192
28/ 3085-92 FU 1550' oil 12 hr.
P/ 101 bo 12 hr. P/ 156 bo 24 hr.
Comp. 87 bopd

13

Co. Lse. No. Sec. T. R.