


Map No. _____ Sec. 13 Twp. 29 R. 5

Well No. 1 Bush _____ Farm _____

~~Little Rock~~ _____ Company _____

United Prodr & Ref. Co **NORTH** 9

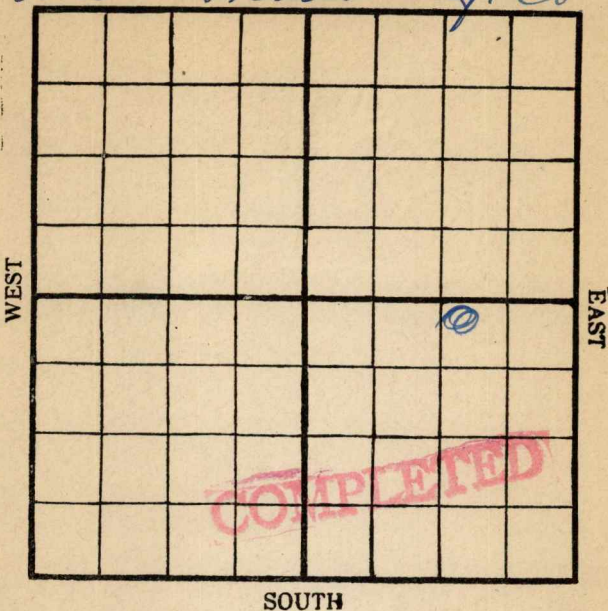

Location _____

Rig Up _____

Drilling Remarks:

Drilling Remarks:

RECORD

PRODUCTION

Cased _____ in. _____ ft.

1st 24 hrs. Nat. _____

Sand _____

1st 24 hrs. after shot _____

Gas _____

Gas _____ cu. ft.

Oil _____

Dry Hole _____

Total Depth _____

Abandoned _____

Well No. 13 Farm 13

76 No. 1 Oil Company

NORTH

Box

WEST

EAST

This 40 acres more
sub-leased
by A. N. Co. to
Sutter et al.
Mark the above name
void

SOUTH

Location -----

Rig Up ✓

Drilling and remarks

RECORD

Cased_____ in. _____ Ft.

Sand

Gas

Oil

Total Depth -----

PRODUCTION

1st 24 hrs. Nat.-----

1st 24 hrs. after shot-----

Gas ----- Cu. Ft.

Dry Hole -----

Abandoned -----

Date _____

2/25, 1918. J. C. Condit Scout

Scout

Map No. K11 Sec. 13 Twp. 29 R. 5Well No. 1 Bush FarmSutter et al Company

NORTH

WEST

EAST

SOUTH

Location ✓Rig Up ✓

Drilling and remarks

This is OK
L.C.C.

RECORD

Cased _____ in. _____ Ft.

Sand _____

Gas _____

Oil _____

Total Depth _____

PRODUCTION

1st 24 hrs. Nat. _____

1st 24 hrs. after shot _____

Gas _____ Cu. Ft.

Dry Hole _____

Abandoned _____


Date

3/7, 1918 Candiff ScoutFirst Report

Map No. _____ Sec. 13 Twp. 39 R. 5Well No. 1 Bush Farm _____
United Producers Company

NORTH

WEST

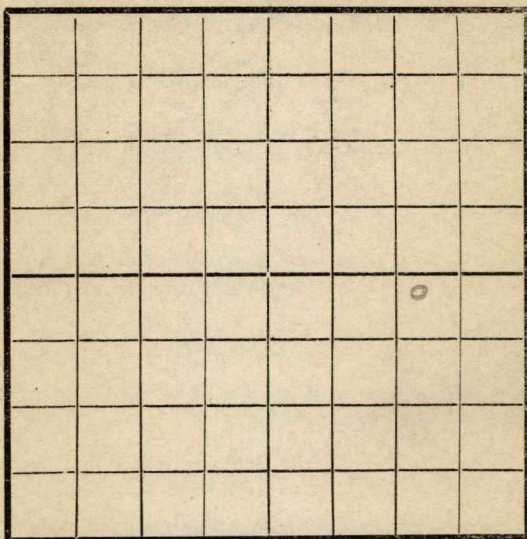

EAST

SOUTH

Location _____

Rig Up _____

Drilling and remarks

200

RECORD

Cased _____ in. _____ Ft.

Sand _____

Gas _____

Oil _____

Total Depth _____

PRODUCTION

1st 24 hrs. Nat. _____

1st 24 hrs. after shot _____

Gas _____ Cu. Ft.

Dry Hole _____

Abandoned _____

Date


4/24, 1918 J. Conley Scout

Map No. _____ Sec. 13 Twp. 39 R. 5

Well No. 1 _____ Farm _____
United Producers Company

NORTH

WEST

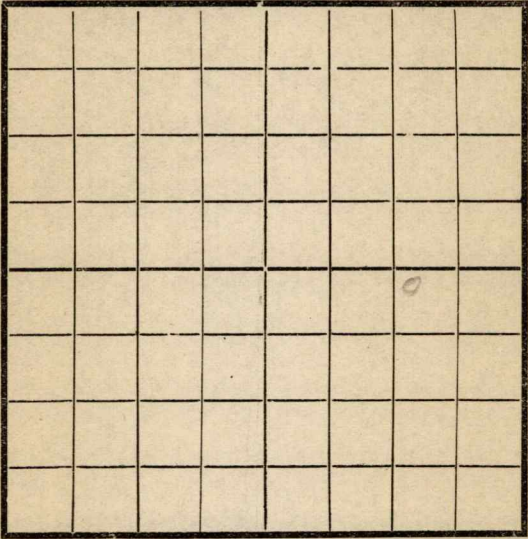

EAST

SOUTH

RECORD

Location _____
Rig Up _____
Drilling and remarks

Cased _____ in. _____ Ft.
Sand _____
Gas _____
Oil _____
Total Depth _____

PRODUCTION

1st 24 hrs. Nat. _____
1st 24 hrs. after shot _____
Gas _____ Cu. Ft.
Dry Hole _____
Abandoned _____


Date

5/1, 1918 Cordery Scout

Map No. _____ Sec. 13 Twp. 29 R. 5Well No. 1 Bush Farm
United Producers Company

NORTH

WEST

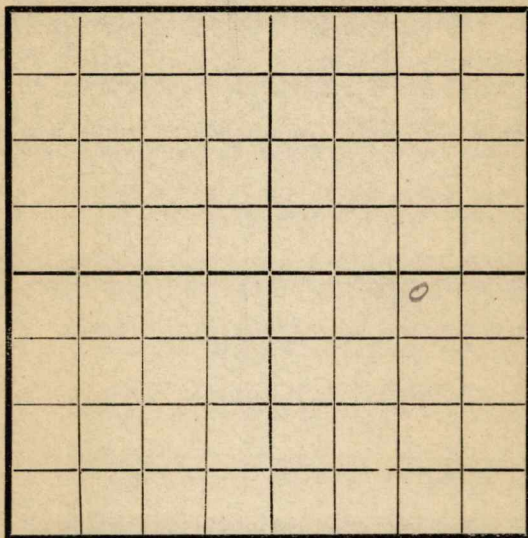

EAST

SOUTH

Location _____

Rig Up _____

Drilling and remarks

700

RECORD

Cased _____ in. _____ Ft.

Sand _____

Gas _____

Oil _____

Total Depth _____

PRODUCTION

1st 24 hrs. Nat. _____

1st 24 hrs. after shot _____

Gas _____ Cu. Ft.

Dry Hole _____

Abandoned _____


Date

5/8, 1918 8 Conley Scout

Map No. _____ Sec. 13 Twp. 29 R. 5Well No. 1 Bush Farm _____
United Petroleum Company

NORTH

WEST

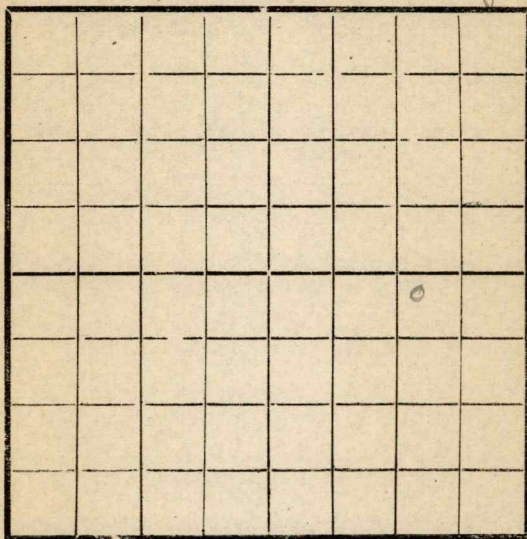

EAST

SOUTH

RECORD

Location _____

Cased _____ in. _____ Ft.

Rig Up _____

Sand _____

Drilling and remarks

Gas _____

Oil _____

Total Depth _____

PRODUCTION

1st 24 hrs. Nat. _____

1st 24 hrs. after shot _____

Gas _____ Cu. Ft.

Dry Hole _____

Abandoned _____


Date

5/15, 1918 C. C. Cady Scout

Map No. _____ Sec. 13 Twp. 29 R. 5Well No. 1 Bush _____ Farm
United Producers Company

NORTH

WEST

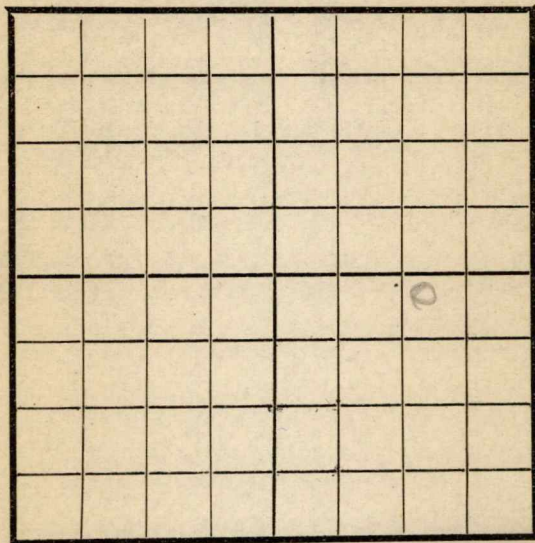

EAST

SOUTH

Location _____

Rig Up _____

Drilling and remarks

SD 700

RECORD

Cased _____ in. _____ Ft.

Sand _____

Gas _____

Oil _____

Total Depth _____

PRODUCTION

1st 24 hrs. Nat. _____

1st 24 hrs. after shot _____

Gas _____ Cu. Ft.

Dry Hole _____

Abandoned _____

Date

5/22, 1918 C. Condy Scout

Map No. _____ Sec. 13 Twp. 29 R. 5Well No. 1 _____ Farm United Prod Company

NORTH

WEST

EAST

SOUTH

Location _____

Rig Up _____

Drilling and remarks

*Skidding
Rig*

RECORD

Cased _____ in _____ Ft.

Sand _____

Gas _____

Oil _____

Total Depth _____

PRODUCTION

1st 24 hrs. Nat. _____

1st 24 hrs. after shot _____

Gas _____ Cu. Ft.

Dry Hole _____

Abandoned _____

Date

5/29, 1918 C. Conley Scout

Map No. _____ Sec. 13 Twp. 29 R. 5
Well No. 1 Bush
United Producing Company
Contractor _____

NORTH

WEST

EAST

SOUTH

Location _____

Rig up.....

Drilling and Remarks:

RECORD

Cased-----in., -----ft.

Sand_____

Gas _____

Oil _____

Total Depth_____

PRODUCTION

1st 24 hrs. Nat. -----

1st 24 hrs. after shot.....

Gas.....Cu. Ft.

Dry Hole

Abandoned.....

Date _____

6/19 191 J. C. Carley Scout

Map No. _____ Sec. 13 Twp. 29 R. 5Well No. 13United Producing Company

Contractor _____

NORTH

WEST

EAST

SOUTH

Location _____

Rig up _____

Drilling and Remarks:

980

RECORD

Cased _____ in., _____ ft.

Sand _____

Gas _____

Oil _____

Total Depth _____

PRODUCTION

1st 24 hrs. Nat. _____

1st 24 hrs. after shot _____

Gas _____ Cu. Ft.

Dry Hole _____


Abandoned _____

Date

6/26 1918 C. Condit Scout

Map No. _____ Sec. 13 Twp. 29 R. 5Well No. 11 BushUnited Producers CompanyBruse Hyde ContractorAugusta NORTH Ko

WEST

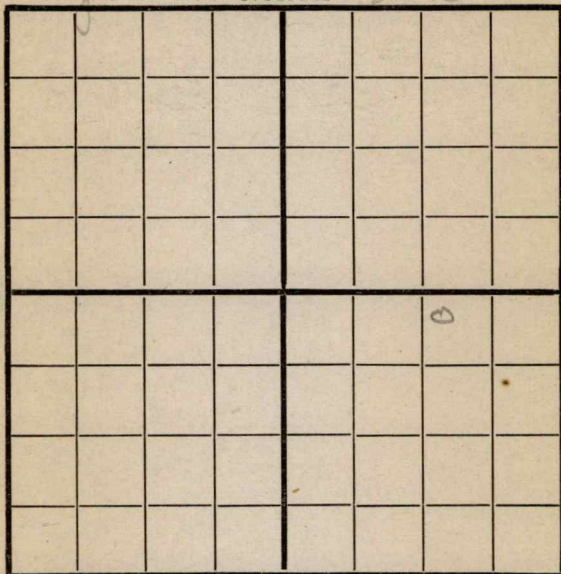

SOUTH

EAST

RECORD

Location _____

Cased _____ in., _____ ft.

Rig up _____

Sand _____

Drilling and Remarks:

Gas _____

Oil _____

Total Depth _____

1200

PRODUCTION

1st 24 hrs. Nat. _____

1st 24 hrs. after shot _____

Gas _____ Cu. Ft.

Dry Hole _____

Abandoned _____

Date

7/3 191 S. Conley Scout

Map No. _____ Sec. 13 Twp. 29 R. 5

Well No. 1 Bush


United Producers Company

Contractor _____

NORTH

WEST

EAST

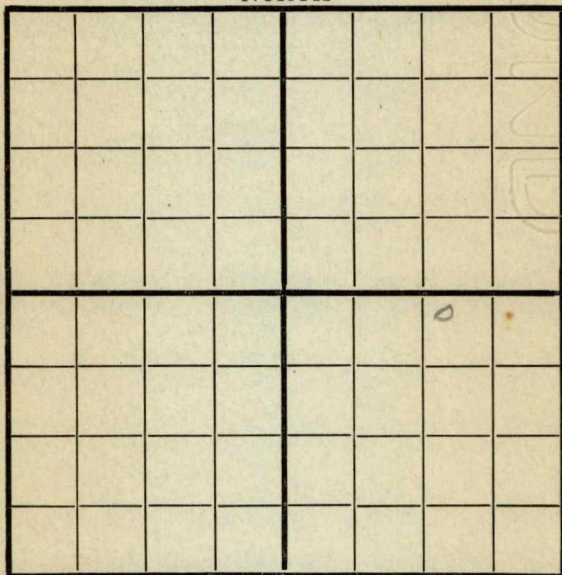

SOUTH

Location _____

Rig up _____

Drilling and Remarks:

1750

RECORD

Cased _____ in., _____ ft.

Sand _____

Gas _____

Oil _____

Total Depth _____

PRODUCTION

1st 24 hrs. Nat. _____

1st 24 hrs. after shot _____

Gas _____ Cu. Ft.

Dry Hole _____

Abandoned _____

Date

2/10 1918

C. C. Cady Scout


Scout

Map No. _____ Sec. 13 Twp. 29 R. 5
 Well No. 1 Bush
United Producing & Ref. Company
 _____ Contractor

NORTH

WEST

EAST

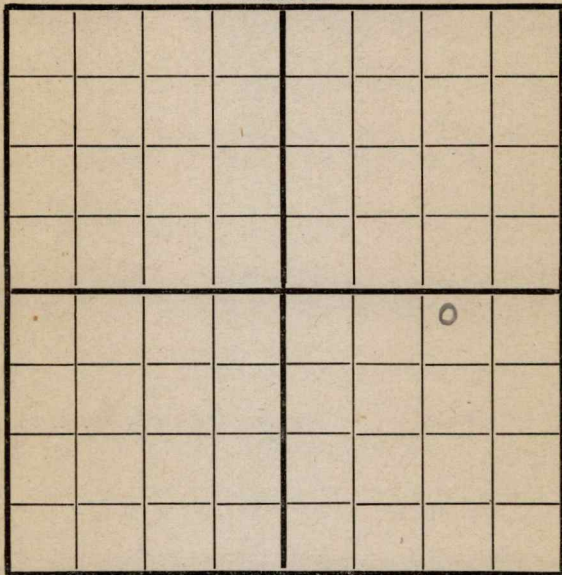

SOUTH

200 S. 4 L x 1120 E L

Location _____

Rig up _____

Drilling and Remarks:

2200

RECORD

Cased _____ in., _____ ft.

Sand _____

Gas _____

Oil _____

Total Depth _____

PRODUCTION

1st 24 hrs. Nat. _____

1st 24 hrs. after shot _____

Gas _____ Cu. Ft.

Dry Hole _____

Abandoned _____

Date

7/31

191

8 C. C. C.

Scout

Map No. _____ Sec. 13 Twp. 29 R. 5
Well No. 1 Bussell
United Producing Company

Contractor _____

NORTH							
WEST							
SOUTH							
EAST							

200 N
Location 1120 E
Rig up _____
Drilling and Remarks:

2350

RECORD

Cased _____ in., _____ ft.
Sand _____
Gas _____
Oil _____
Total Depth _____

PRODUCTION

1st 24 hrs. Nat. _____
1st 24 hrs. after shot _____
Gas _____ Cu. Ft.
Dry Hole _____
Abandoned _____

Date

8/7

191

P. Cudry


Scout

Map No. _____ Sec. 13 Twp. 29 R. 5Well No. 1300United Producing & Ref. Company_____
Contractor

NORTH

WEST

EAST

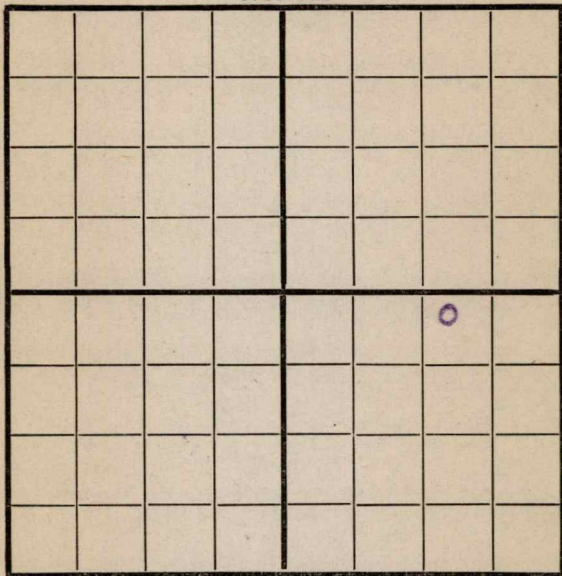

SOUTH

Location 200 N 1120 E

Rig up _____

Drilling and Remarks:

2400

RECORD

Cased _____ in., _____ ft.

Sand _____

Gas _____

Oil _____

Total Depth _____

PRODUCTION

1st 24 hrs. Nat. _____

1st 24 hrs. after shot _____

Gas _____ Cu. Ft.

Dry Hole _____

Abandoned _____

Date


8/14 191 E. C. Cuddy

Scout

Map No. _____ Sec. 13 Twp. 29 R. 5
 Well No. 1 Bussler
United Producing Company
 _____ Contractor

NORTH

WEST

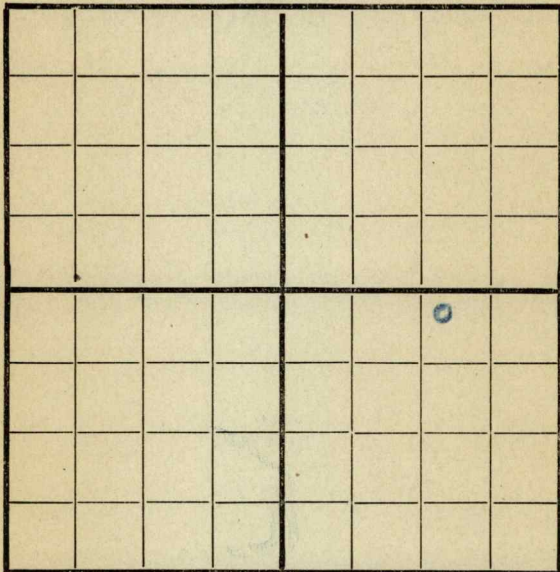

EAST

SOUTH

200' N - 1120' E

Location _____

Rig up _____

Drilling and Remarks:

Testing
2400

RECORD

Cased _____ in., _____ ft.

Sand _____

Gas _____

Oil _____

Total Depth _____

PRODUCTION

1st 24 hrs. Nat. _____

1st 24 hrs. after shot _____

Gas _____ Cu. Ft.

Dry Hole _____

Abandoned _____

Date

8/21 1918 Cumley Scout

Map No. 511 Sec. 13 Twp. 29 R. 5


Well No. 1 Borehole

United Producing & Ref Company
Contractor

NORTH

WEST

EAST

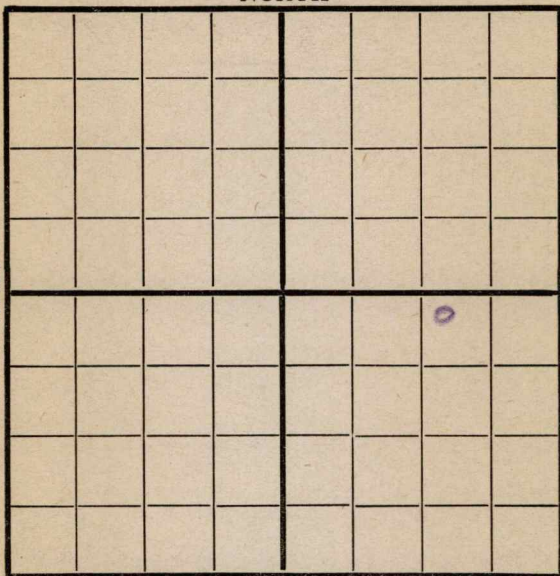

200 ft - 1120 ft SOUTH

RECORD

Location _____

Cased _____ in., _____ ft.

Rig up _____

Sand _____

Drilling and Remarks:

Gas _____

Oil _____

Total Depth _____

PRODUCTION

1st 24 hrs. Nat. _____

1st 24 hrs. after shot _____

Gas _____ Cu. Ft.

Dry Hole _____

Abandoned _____

Date


10/2 1918 S. Conley Scout

Map No. K 11 Sec. 13 Twp. 29 R. 5Well No. 1 BushUnited Producing & Ref Company Contractor

NORTH

WEST

EAST

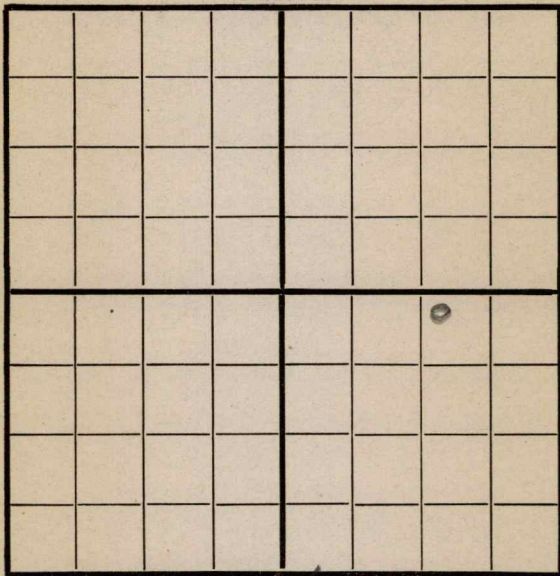

SOUTH

200' N - 1120'

Location _____

Rig up _____

Drilling and Remarks:

RECORD

Cased _____ in., _____ ft.

Sand _____

Gas _____

Oil _____

Total Depth _____

PRODUCTION

1st 24 hrs. Nat. _____

1st 24 hrs. after shot _____

Gas _____ Cu. Ft.

Dry Hole _____

Abandoned _____

Date


9/25 8 Conley Scout

Map No. 1511 Sec. 13 Twp. 29 R. 5
 Well No. 1 Bush
United Producing & Ref. Company
 Contractor

NORTH

WEST

EAST

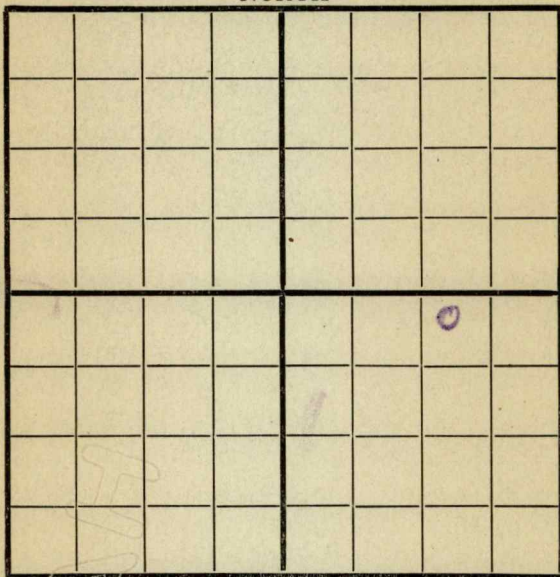

SOUTH

RECORD

Location _____

Cased _____ in., _____ ft.

Rig up _____

Sand _____

Drilling and Remarks:

Gas _____

Oil _____

Total Depth _____

PRODUCTION

1st 24 hrs. Nat. _____

1st 24 hrs. after shot _____

Gas _____ Cu. Ft.

Dry Hole _____

Abandoned _____

Date

9/18 1918 J. C. Cuddy Scout


Map No. K 11 Sec. 13 Twp. 29 R. 5Well No. 1 BushUnited Producing & Ref Company

Contractor

NORTH

WEST

EAST

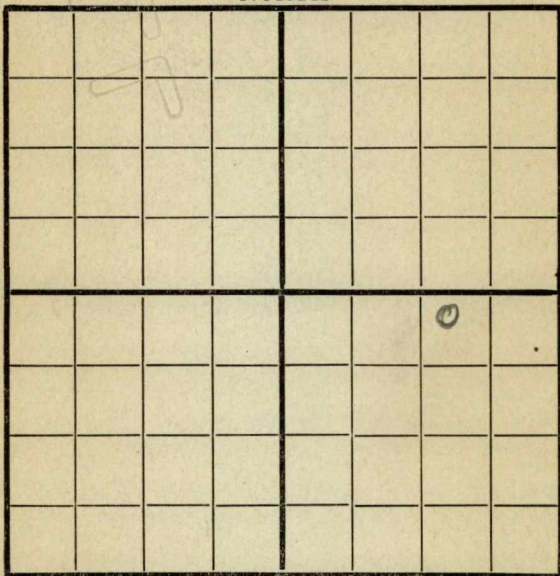

SOUTH

200' N - 1120' E

RECORD

Location

Cased in., ... ft.

Rig up

Sand

Drilling and Remarks:

Gas

Oil

Total Depth

PRODUCTION

1st 24 hrs. Nat.

1st 24 hrs. after shot

Gas Cu. Ft.

Dry Hole

Abandoned

Date

9/11

191

C. Condy

Scout


Map No. 1511 Sec. 13 Twp. 29 R. 5Well No. 1 BushUnited Producing Co. Company

Contractor

NORTH

WEST

EAST

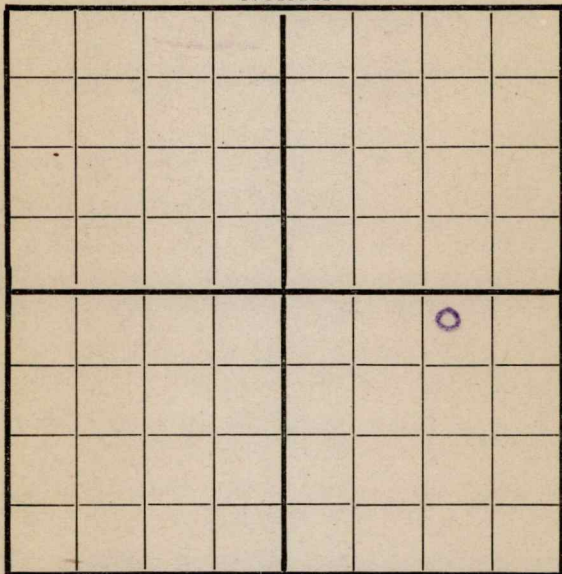

SOUTH

Location _____

Rig up _____

Drilling and Remarks:

2730

RECORD

Cased _____ in., _____ ft.

Sand _____

Gas _____

Oil _____

Total Depth _____

PRODUCTION

1st 24 hrs. Nat. _____

1st 24 hrs. after shot _____

Gas _____ Cu. Ft.

Dry Hole _____

Abandoned _____

Date

9/4

191

J. C. Candoff


Scout

Map No. 171 Sec. 13 Twp. 29 R. 5Well No. 1 Bush
United Producing Company
Contractor

NORTH

WEST

EAST

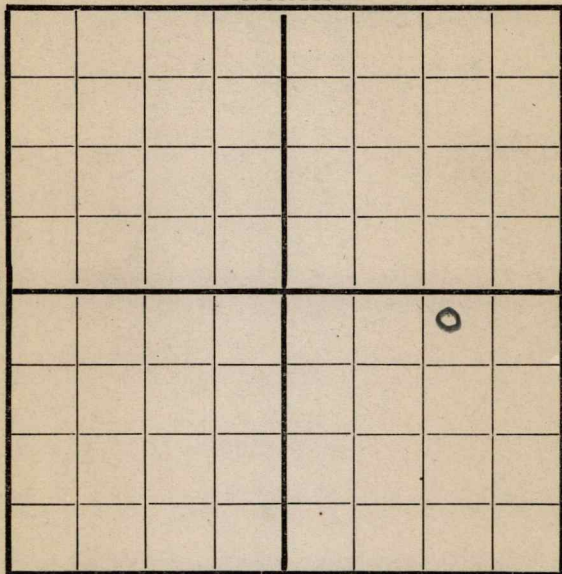

SOUTH

Location _____

Rig up _____

Drilling and Remarks:

2460

RECORD

Cased _____ in., _____ ft.

Sand _____

Gas _____

Oil _____

Total Depth _____

PRODUCTION

1st 24 hrs. Nat. _____

1st 24 hrs. after shot _____

Gas _____ Cu. Ft.

Dry Hole _____

Abandoned _____

Date

8/28 191 8 P. M. Scout

Well No. 1 Bush

United Pro. & Ref. Company

Stinson & Co. Inc. Contractor

August NORTH Kansas

WEST

EAST

COMPLETED

SOUTH

Location _____

Rig up-----

Drilling and Remarks:

Shot with
30 gr -
Est at
35 lbs

RECORD

Cased _____ in., _____ ft.

Sand 2820-2893

Gas

Oil _____

Total Depth_____

PRODUCTION

1st 24 hrs. Nat. -----

1st 24 hrs. after shot-----

Gas.....Cu. Ft.


Dry Hole

Abandoned.....

Date _____

Date 10/17 1941 J. C. Conley Scout

Map No. K 11 Sec. 13 Twp. 29 R. 5
 Well No. 1 Bush
United Producing & Ref Company
 Contractor

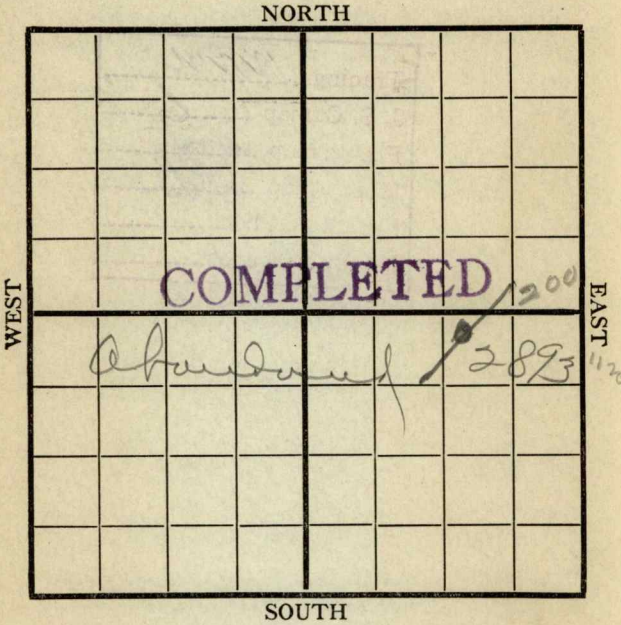

	RECORD
Location _____	Cased _____ in., _____ ft.
Rig up _____	Sand <u>2820-2893</u>
Drilling and Remarks: <u>This well completed</u> <u>and reported good</u> <u>for 35 bbls - Sept 11 -</u> <u>was shot with 30 grs</u> <u>I see no good and</u> <u>same is being</u> <u>abandoned</u>	Gas _____
	Oil _____
	Total Depth _____
	PRODUCTION
	1st 24 hrs. Nat. _____
	1st 24 hrs. after shot _____
	Gas _____ Cu. Ft.
	Dry Hole _____
	Abandoned <u>2893</u>

Date 10/31 1918 C. C. C. C. Scout