


Section 2 Township 16 Range 14-W

Well No. #5 Schneider "C"

Company Shell

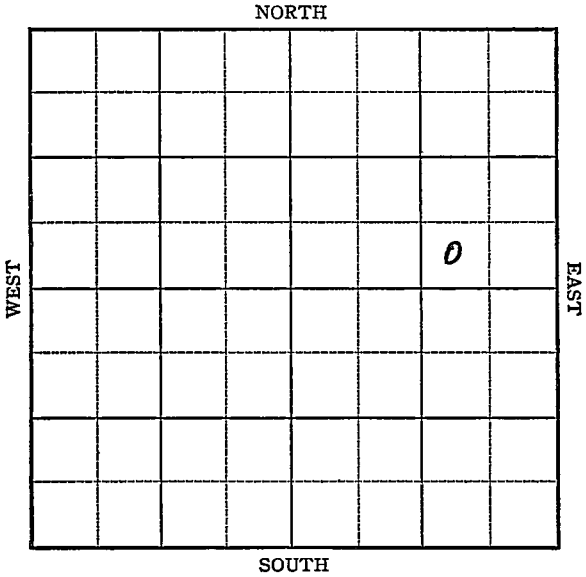

**KANSAS**

Barton

Sec. 2 Twp. 16 R. 14-W

Well No. #5 Schneider "C" Farm

Shell Company

(Trapp)


\_\_\_\_\_ Ft. from N. Line

330 Ft. from S. Line

990 Ft. from E. Line

\_\_\_\_\_ Ft. from W. Line

Elev. 1866

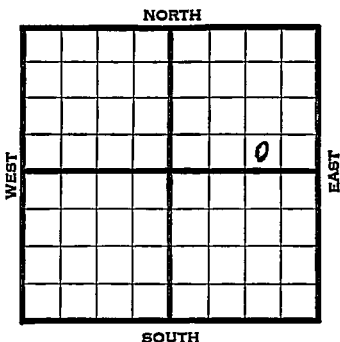

1941	REPORT
11/25	Location
12/4	8" - 635' Drlg. 1572'
12/11	Topeka 27 68
	Drlg. 3002
12/18	Lans 3089
	Arb. 3293
	4" @ 3294 TD 3304
	1100' oil 6 hrs.
12/24	T.D. 3309' 3000 acid.
	Swab 132 oil in 5 hours.
12/30	Arb. 3293 4" @ 3294
	TD 3309
	3000 acid
	Echo. Potential 593
	39 Grav.
	<b>COMPLETED</b>

Map No. K-23 Sec. 2 Twp. 16 R. 14W

Well No. 5 Schneider "C"

Shell

Company

**FIRST REPORT**

Contractor

SW SE NE

**SECTION PLAT**


\_\_\_\_\_ Ft. from N. Line

330 Ft. from S. Line

990 Ft. from E. Line

\_\_\_\_\_ Ft. from W. Line

**TRAPP POOL**

**RECORD**

Location XX

Cased \_\_\_\_\_ in., \_\_\_\_\_ ft.

Rig up \_\_\_\_\_

Sand \_\_\_\_\_

Drilling and Remarks:

Gas \_\_\_\_\_

Oil \_\_\_\_\_

Total Depth \_\_\_\_\_

**PRODUCTION**

1st 24 hrs. Nat. \_\_\_\_\_

1st 24 hrs. after shot \_\_\_\_\_

Gas \_\_\_\_\_ Cu. Ft.

Dry Hole \_\_\_\_\_

Abandoned \_\_\_\_\_

Date

NOV 25 1941 19

S. J. LEWIS Scout

Map No. 73 Sec. 2 Twp. 16 R. 14WWell No. 5 Schneider "C"

Shell

Company

**COMPLETED**

Contractor

SW SE NE

## SECTION PLAT

\_\_\_\_\_ Ft. from N. Line

330 Ft. from S. Line990 Ft. from E. Line

\_\_\_\_\_ Ft. from W. Line

			o

## TRAP POOL

## RECORD

Location \_\_\_\_\_

Cased \_\_\_\_\_ in., \_\_\_\_\_ ft.

Rig up \_\_\_\_\_

Sand \_\_\_\_\_

Drilling and Remarks:

Gas \_\_\_\_\_

Oil \_\_\_\_\_

Total Depth 3309

\_\_\_\_\_

## PRODUCTION

1st 24 hrs. Nat. \_\_\_\_\_

1st 24 hrs. after shot \_\_\_\_\_

Gas \_\_\_\_\_ Cu. Ft.

Dry Hole \_\_\_\_\_

Abandoned \_\_\_\_\_

*Per X 3293**4" @ 3294**3000 acid**Echrt Pt X 593**390 Gr*

Date

DEC 30 1941

19

S. J. LEWIS Scout