

Section 21 Township 14 Range 13 WWell No. # 2 RoggCompany El Reco Ref.

NORTH

14

SOUTH

EAST

WEST

0

21

14

13W

Sec. _____ Twp. _____ R. _____

Well No. #2 Rpgg Farm _____

ElReco Refg.

Company _____

Carter Drlg.

Contractor _____

Hall-Gurney Pool

Ft. from N. Line

990


Ft. from S. Line

330

Ft. from E. Line

Ft. from W. Line

NE SE SW

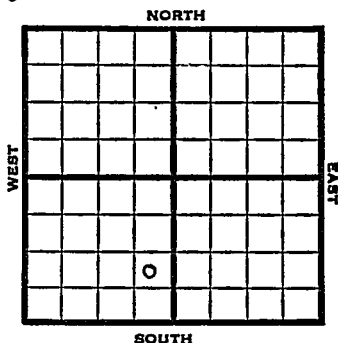

1952

Elev. 1764' REPORT

10/8 RUR

10/15 10" @ 429

Anhy 713

8" @ 718'

10/22 Drlg. 1825'

10/29 1st Tarkio 2287' 2nd Tarkio 2307-12

TD 12 gal OPH Hole caved

CO 5" @ 2308'

11/5 DD 2313 TD S/ 3 galoph Hydra.
S/ 3-1/4 Boph

11/12 NR

11/20 "

11/26 Spud 10-9-52

Oil well TD 2313' 10" @ 429


Anhy 713' 8" @ 718 1st Tarkio 2287'

2nd Tarkio 2307' TD 2312' 12 GOPH

5" @ 2308 DD 2313' S/3 GOPH

Hydro. S/3 1/4 BOPH Comp. 30 BOPD

COMPLETED

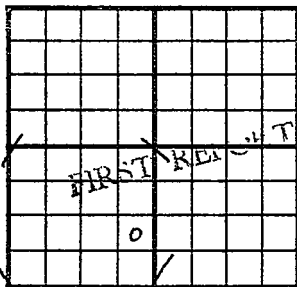County Russell State KansasSec. 21 (Blk. Twp.) 14 (Sur. Rge.) 13W Map No.Operator ElReco Ref.Well No. 2 Farm RoggElev. Location NE SE SW990 Ft. From S Line SW330 Ft. From E Line Quarter1st. Report OCT 8 1959

Completion

Remarks


Garter Drlg. - Contr.

Spudding Date

Drlg. Data Hall-Gurney PoolRUR

J. G. McGEHEE

County Russell State Kansas
 Sec. 21 (Blk.) 14 (Sur.) 13W Map No.
 Operator Elreco Ref.
 Well No. 2 Farm Rogg
 Elev. 1764 Location NE SE SW

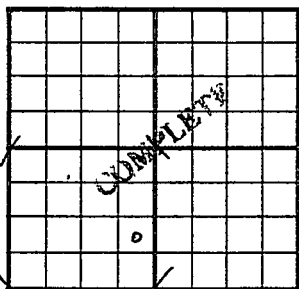

990 Ft. From S Line SW
330 Ft. From E Line Quarter
 1st. Report
 Completion NOV 26 1952
 Remarks Hall-Gurney Pool
Carter Drlg. - Contr.
 Spudding Date 10-9-52

Drlg. Data Oil well TD 2313
10" @ 429 Anhy 713 8" @ 718
1st Tarkio 2287 2nd Tarkio 2307 TD 2312
12 goph 5" @ 2308 DD 2313 S/ 3 goph
Hydro. S/ 3½ boph Comp. 30 bond

J. G. McGEHEE