


Barton

SECTION 4 TOWNSHIP 16S RANGE 11W

WELL NO. #1 Karst

COMPANY Rudy Herman

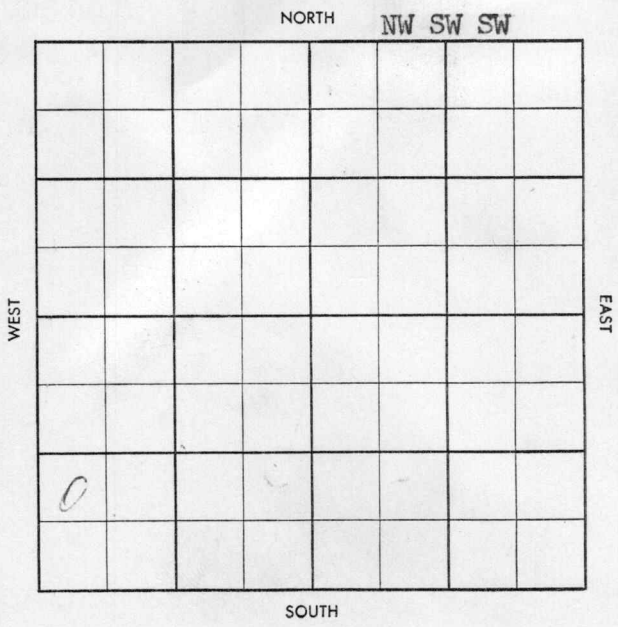

~~XXXXXXXXXX~~
CORRECTION

FORM 513 SUNRAY

13

County Barten Elev. 1930
 Sec. 4 Twp. 16 Rgs. 14W
 Company Rudy Herman
 Farm Name Karst No. 21

Co.

TOPS	DEPTH	LOG	DATUM
Anh.	915		
Tp.	2852		
H.	3077		
Tr.			
Dg.			
BL.			
L.			
K.C.	3143		
B.K.C.			
Ce.			
C.			
M.			
M.			
K.			
Mz.			
Ma.			
V.			
S.			
S.			
A	3380		
R.			
PE.			
G.			
T.D.	3405		

Loc. in Sec. NW SW SW

Geol. _____
 Concr. _____

Pool Nuss

**FIRST REPORT
COMPLETE**

0	MAR 5 '58
---	-----------

Lse.

No.

Sec.

T.

R.

Date Comm. 858 270
 Location JUL 3 '57 JUL 10 '57 7-8-57
Ø 50 JUL 17 '57 Ø 3293 JUL 24 '57
DST 3368-82 1hr 3' Md BHP
Ø DST 3382-3405 1hr 20' OCM
122/20" DST 3400-3405 1hr 10'
gas 330' HO CM 837/20" 5 1/2
3385 / waqt JUL 31 '57 CO 3405 FU
1200 oil no/w 1/4 \$ 4 Boph no/w
TER AUG 3 '57 AUG 14 '57 AUG 21 '57 AUG 28 '57 SEP 4 '57

SEP 11 '57 SEP 18 '57

SEP 25 '57 OCT 2 '57 OCT 9 '57 OCT 16 '57
 OCT 23 '57 OCT 30 '57 NOV 6 '57 NOV 13 '57
 NOV 20 '57 NOV 27 '57 WOP DEC 4 '57 DEC 11 '57
 DEC 18 '57 DEC 26 '57 JAN 2 '58 P 50-55 BOD
 + 10-1590 W 24 hrs
 JAN 8 '58 JAN 15 '58 JAN 22 '58 JAN 29 '58 FEB 5 '58
 FEB 12 '58 FEB 19 '58 FEB 26 '58 MAR 5 '58 P 501
 P 15 BOD + 1590 W

4-16-14W

ms swan