

Map No. _____ Sec. 13 Twp. 29 R. 5Well No. John Bush Farm __________ a # 1 Oil Company _____

NORTH

WEST

EAST

SOUTH

Location _____

Rig Up _____

Drilling Remarks:

Drilling Remarks:

RECORD

PRODUCTION

Cased _____ in _____ Ft.

1st 24 hrs. Nat. _____

Sand _____

1st 24 hrs. after shot _____

Gas _____

Gas _____ Cu. Ft.

Oil _____

Dry Hole _____


Total Depth _____

Abandoned _____

Butler

Map No. *K11* Sec. *13* Twp. *29* R. *5*
 Well No. *John Bush* Farm
A & I Oil Company

NORTH

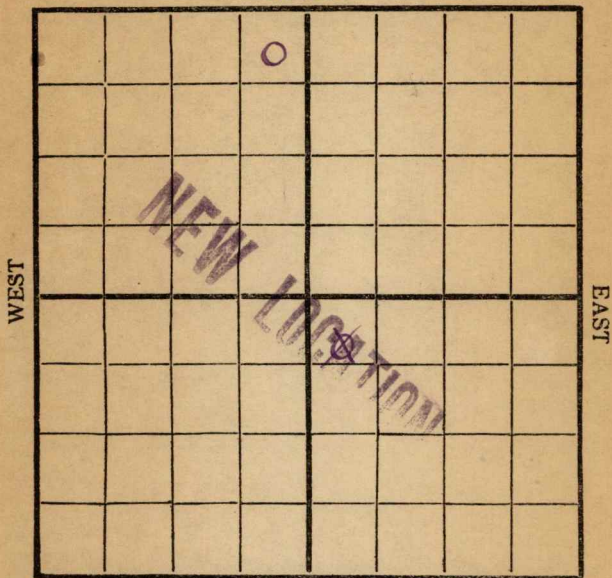

WEST

EAST

SOUTH

Location _____
 Rig Up _____
 Drilling and remarks _____

*Timber on
 Ground*

RECORD

Cased _____ in. _____ Ft.
 Sand _____
 Gas _____
 Oil _____
 Total Depth _____

PRODUCTION

1st 24 hrs. Nat. _____
 1st 24 hrs. after shot _____
 Gas _____ Cu. Ft.
 Dry Hole _____
 Abandoned _____

Date

FEB 17 1917, 191


C. J. Crocker Scout

Map No. _____ Sec. 13 Twp. 29 R. 5Well No. 1 Radner FarmA # 1 Company

NORTH

WEST

EAST

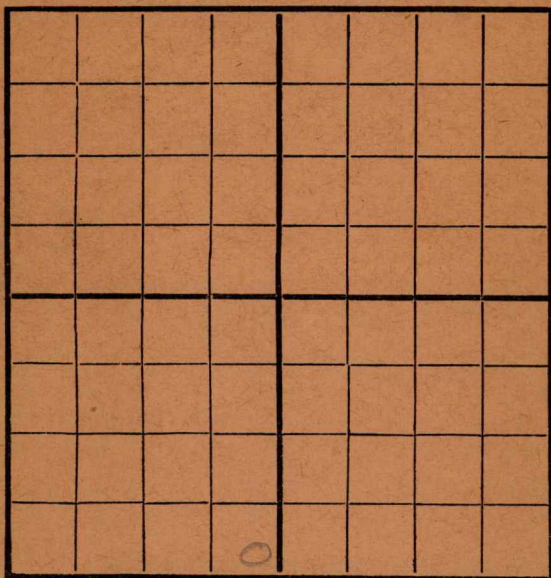

SOUTH

Location _____

Rig Up _____

Drilling and remarks _____

RECORD

Cased _____ in. _____ Ft.

Sand _____

Gas _____

Oil _____

Total Depth _____

PRODUCTION

1st 24 hrs. Nat. _____

1st 24 hrs. after shot _____

Gas _____ Cu. Ft.

Dry Hole _____

Abandoned _____

Date

8/1, 191 7 Cardiff Scout