


Map No. _____ Sec. 13 Twp. 29 R. 5

Well No. 3 Bush Farm _____
Vannaman & Dairdson Company

NORTH

9

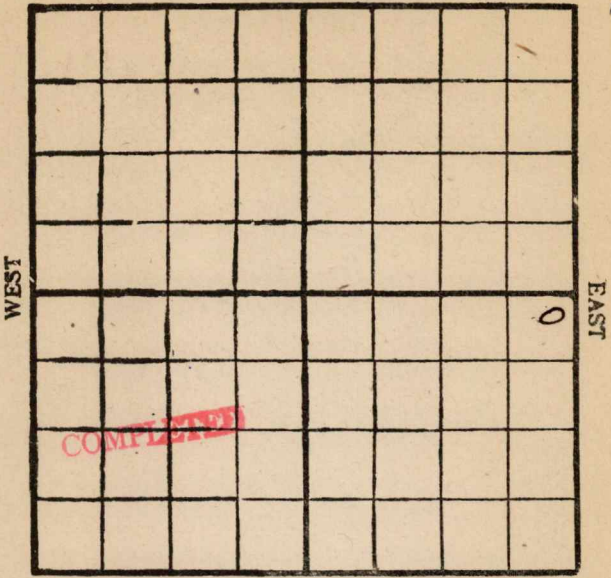

SOUTH

Location -----

Rig Up -----

Drilling Remarks:

Drilling Remarks:

9-5 sand (oil) 2770-2806'
Shot 40 gts 100 bbls.

RECORD

PRODUCTION

Cased _____ in. _____ ft.

1st 24 hrs. Nat. _____

Sand _____

1st 24 hrs. after shot _____

Gas _____

Gas _____ cu. ft.

Oil _____

Dry Hole _____

Total Depth _____


Abandoned _____

Map No. K 11 Sec. 13 Twp. 29 R. 5

Well No. 3 Bush
Vanimmun & Davidson Company

Contractor

NORTH

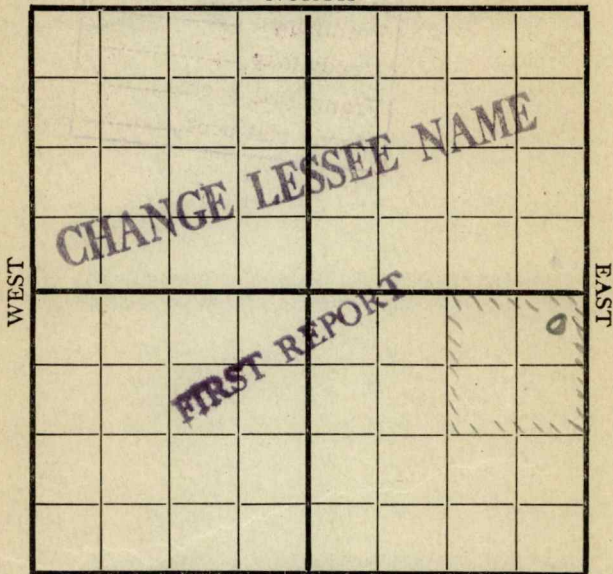

250 E

SOUTH

1070 S

Location _____

Rig up _____

Drilling and Remarks:

RECORD

Cased _____ in., _____ ft.

Sand _____

Gas _____

Oil _____

Total Depth _____

PRODUCTION

1st 24 hrs. Nat. _____

1st 24 hrs. after shot _____

Gas _____ Cu. Ft.

Dry Hole _____

Abandoned _____

Date

4/15

191

9

Pyle

Scout