


Barton

KANSAS

SECTION 5 TOWNSHIP 16S RANGE 14W

WELL NO. #1 Nuss "D"

COMPANY Rudy Herman

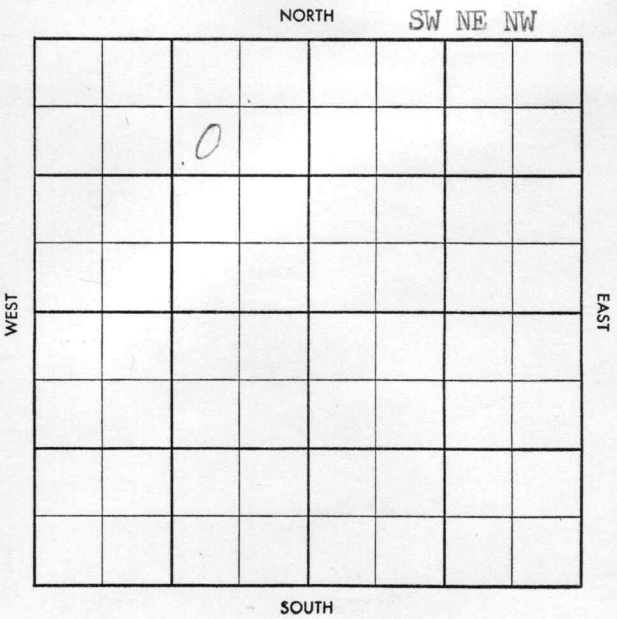



CO. Barton ELEV. 1901

SEC. 5 TWP. 16 RGE. 14W

COMPANY Rudy Herman NO. 1

OCT 23 '57

CO.

ABANDONED

FARM Nuss "D"

LOC. SW NE NW

USE

A 905
TP 2825
HB 3054
TR 3072
L 3116
C 3366
A 3387
TD 3408

GEOL. \_\_\_\_\_

CONTR. Jackson Tools

POOL Nuss

SPUD 10-7-57

Location

OCT 9 '57 RUR

8" 325

3103 OCT 23 '57

DST 2989-3014

60" 50' M SPOIL.

NO.

SEC.

TWP.

RGE.

BHP 825/20" DST 3150-58 60"

120' GIP - see 90' HD & GCM

600 SW BHP 610/20"

no log

D & A