

BARTON

KANSAS

5

16S

11W


SECTION _____ TOWNSHIP _____ RANGE _____

#1 Nuss

WELL NO. _____

COMPANY Rudy Herman

NORTH

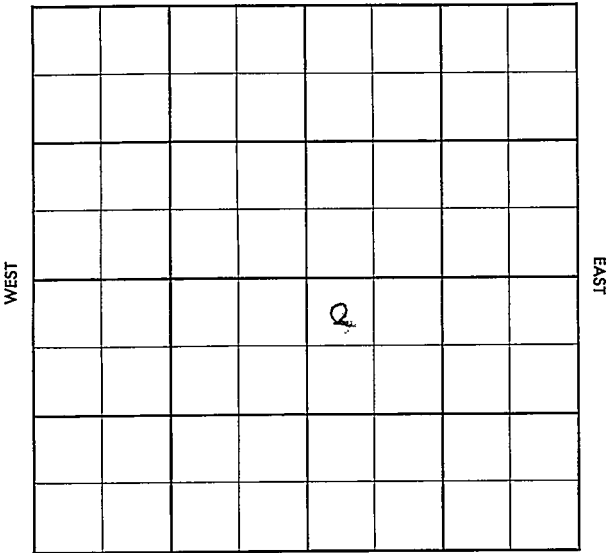

SOUTH

Barton


SEC. 5	TWP. 16S	R. 11W
-----------	-------------	-----------

WELL NO. 1 Nuss. FARM

COMPANY
Rudy Herman
CONTRACTOR

Wood Drlg.
Nuss

_____ FT. FROM N. LINE
 _____ FT. FROM S. LINE
 _____ FT. FROM E. LINE
 _____ FT. FROM W. LINE

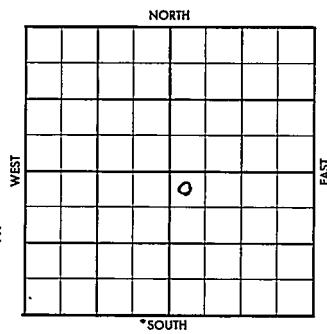

NW NW SE DS - N $\frac{1}{2}$ SE $\frac{1}{4}$

Champlin-FO

1956	ELEVATION	REPORT
------	-----------	--------

6-20
 Comm. 6-14-56
 8" @315 w/200 sx
 Drlg. 2385'
 Anh. 925',

County Barton Elev. _____
 Sec. 5 Twp. 10S Rge. 1/W
 Company Rudy Heaman
 Farm Name Nuss No. 1

TOPS	DEPTH	LOG	DATUM
Anh.	925		
Tp.			
H.			
Tr.			
Dg.			
Bl.			
L.			
K.C.			
B.K.C.			
Ce.			
C.			
M.			
M.			
K.			
Mz.			
Ma.			
V.			
S.			
S.			
A.			
R.			
PE.			
G.			
T.D.			

Loc. in Sec. _____
 NW NW SW
 DS - N $\frac{1}{2}$ SE $\frac{1}{4}$
 Champlin-FO
 Geol. _____
 Contr. _____
 Wood Drlg.
 Pool
 Nuss

FIRST REPORT

Date Comm. 6-14-56
8" 315 w/200 sx; D 2385

JUN 20 '56

1715

Co.
Lse.
No.
Sec.
T.
R.

County Barton Elev. 1920
 Sec. 5 Twp. 10S Rge. 14W
 Company Rudy Hernan
 FarmName Nuss No. 1

TOPS	DEPTH °	LOG	DATUM
Anb.	925		
Top.	2852		
H.	3080		
Tr.	3103		
Dg.			
Bl.			
L.	3143		
K.C.			
B.K.C.			
Ce.			
C.			
M.			
M.			
K.			
Mz.			
Mg.			
V.			
S.			
S.			
A.	3385		
R.			
PE.			
G.			
TR.	3395		

Loc. in Sec. NW NW SE
DS - N¹/₂SE¹/₄
 Champlin-FO
 Geol. _____
 Contr. _____
 Wood Drlg. new zone
 Pool Nuss

COMPLETE

/

SEP 26 '56

Date Comm. 6-14-56
8" 315 #1/200 sx; D 2385 JUN 27 '56

DST 3169-87 30" rec 3' Md
BHP 0/15" DST 3385-95 1hr
rec 110' VHO CM (60% oil) BHP
975 5/2 @ 3387/ JUL 3 '56 JUL 11 '56
CO 3395 @ 1 3/4 Boph no/w 16
hrs N @ 150 BO + 12 BW 24 hrs
T&R JUL 18 '56 JUL 25 '56 AUG 7 '56 AUG 8 '56
1 : " 41" 15.55 AUG 22 '56 AUG 29 '56 P. 50
Bo not w 24 hrs 9400 380

Co. No. Sec. T. R.