

Map No. _____ Sec. 13 Twp. 29 R. S


Well No. 2 Fox Farm _____

A#1049 Company _____

NORTH

WEST

EAST

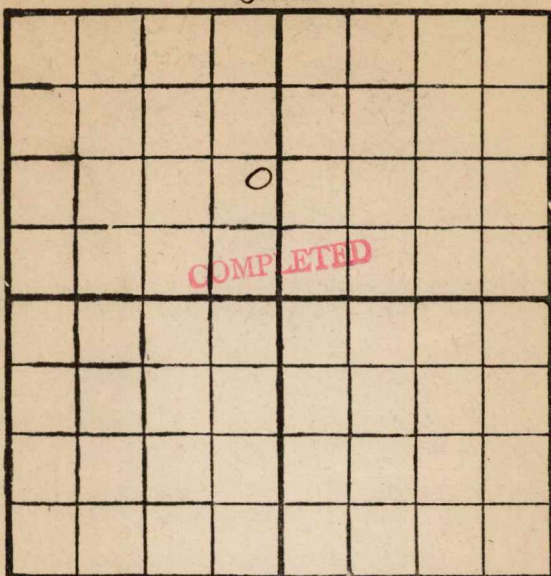

SOUTH

Location _____

Rig Up _____

Drilling Remarks:

Drilling Remarks:

RECORD

Cased _____ in. _____ ft.

Sand _____

Gas _____

Oil _____

Total Depth _____

PRODUCTION

1st 24 hrs. Nat. _____

1st 24 hrs. after shot _____

Gas _____ cu. ft.

Dry Hole _____

Abandoned _____


Map No. K 11 Sec. 13 Twp. 29 R. 5Well No. 2 FoxA. No 1 Oil & Gas Company

Contractor

NORTH

WEST

EAST

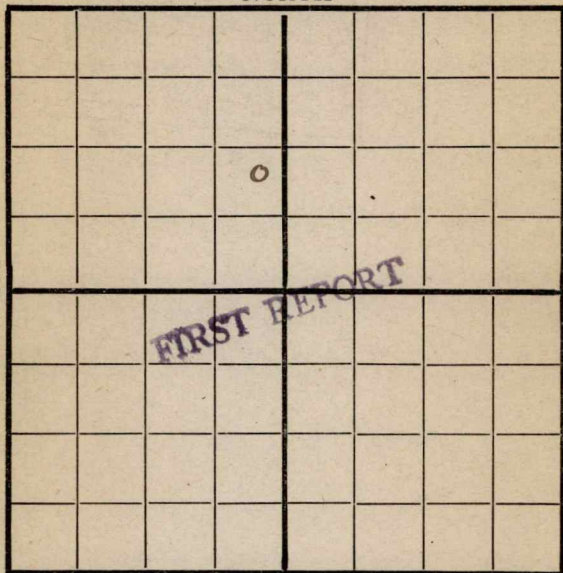

250 E

SOUTH

1070 S

Location _____

Rig up. ☒

Drilling and Remarks:

RECORD

Cased _____ in., _____ ft.

Sand _____

Gas _____

Oil _____

Total Depth _____

PRODUCTION

1st 24 hrs. Nat. _____

1st 24 hrs. after shot _____

Gas _____ Cu. Ft.

Dry Hole _____

Abandoned _____

Date

4/10 1919 Gyle Scout

Map No. K11 Sec. 13 Twp. 29 R. 5Well No. 2 Fox
A-1 Oil & Gas Company

Contractor

NORTH

WEST

EAST



250 E

SOUTH

10705

Location _____

Rig up _____

Drilling and Remarks:

Moved
rig timbers
away

RECORD

Cased _____ in., _____ ft.

Sand _____

Gas _____

Oil _____

Total Depth _____

PRODUCTION

1st 24 hrs. Nat. _____

1st 24 hrs. after shot _____

Gas _____ Cu. Ft.

Dry Hole _____

Abandoned ☒

Date

7/18

1919

Pyle

Scout