

DX 78-1 Summer

KANSAS

Section 36 Township 34 Range 2E

Well No. 15 Airport

Company McNeish & Gralapp

NORTH

15

					0		

WEST

EAST

SOUTH

Summer KANSAS

SEC. 36	TWP. 34	R. 2 E
----------------	----------------	---------------

WELL NO. # 15 Airport FARM

COMPANY McNeish & Gralapp

CONTRACTOR Watson Drlg.


Hilltop Pool
_____ Ft. from N. Line

330 _____ Ft. from S. Line

_____ Ft. from E. Line

990 _____ Ft. from W. Line

SE SW SE

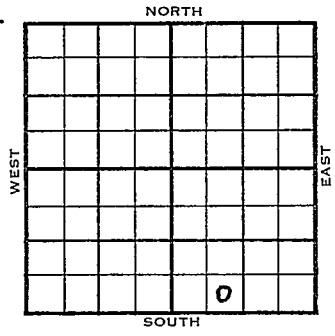

	ELEVATION	REPORT
1955	1215'	

4/27 Spud 4-22-55
8" @ 120
Drlg. 1710'

5/25 Lay 2800; K.C. 2996; Barts 3483;
TD 3539; 8" 120; 5 1/2" 3539; CO:
32/3498-3506; flo 250 bo no wtr
12 hrs; flo 25 bopd no wtr from
Btv. 3498-3506

COMPLETED

