


Map No. _____ Sec. 13 Twp. 29 R. 5
Well No. 2 Fort Farm _____
Maudyler Oil Company _____

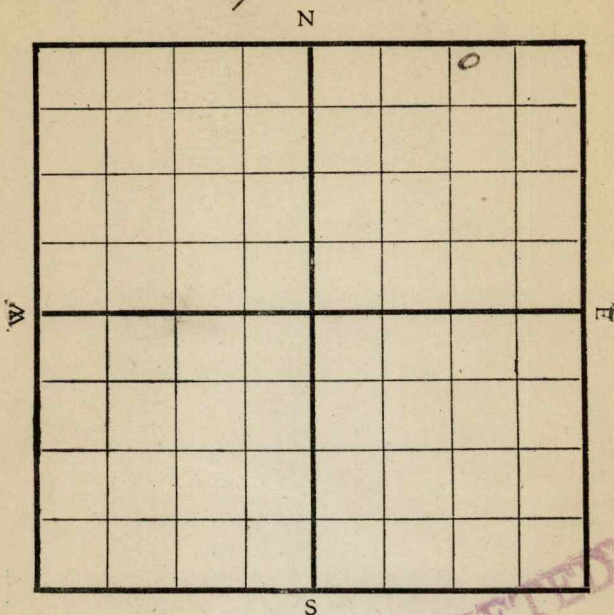

Location _____
Drilling Remarks: _____

Rig Up _____
Drilling Remarks: _____

RECORD

Cased _____ in. _____ ft.
Sand _____
Gas _____
Oil _____
Total Depth _____

PRODUCTION

1st 24 hrs. Nat. _____
1st 24 hrs. after shot _____
Gas _____ cu. ft.
Dry Hole _____
Abandoned _____

Map No. _____ Sec. 13 Twp. 29 R. 5

Well No. 2 Fox _____ Farm


Mandy Lee Oil _____ Company

200 Ft. from N. Line

_____ Ft. from S. Line

1120 Ft. from E. Line

_____ Ft. from W. Line

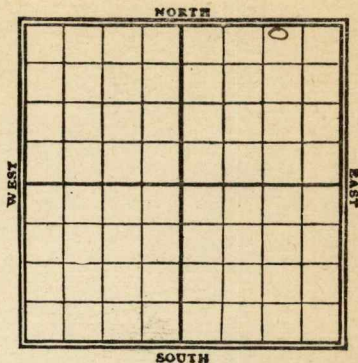

¹⁹²⁰
Date

REPORT

FIRST REPORT

4/24 TO H.

3/14 Ry
23 Loes.

4/2 Mud

9 ✓ + 30.

5/4 Dry 1850

6/8 sand 2834-55 (light water)

3/11 SR 2870

24 ✓ ✓

8/4 SD 2870'

8/29 S.D. 2870'

9/12 dry 2870'

COMPLETED

Map No. K 11 Sec. 13 Twp. 29 R. 5

Well No. 2 Fox

Mandylor Oil Company

Contractor

SECTION PLAT

200 Ft. from N. Line

_____ Ft. from S. Line

1120 Ft. from E. Line

_____ Ft. from W. Line

			0

FIRST REPORT

Location _____

Rig up _____

Drilling and Remarks:

J. O. D.

RECORD

Cased _____ in., _____ ft.

Sand _____

Gas _____

Oil _____

Total Depth _____

PRODUCTION

1st 24 hrs. Nat. _____

1st 24 hrs. after shot _____

Gas _____ Cu. Ft.

Dry Hole _____

Abandoned _____

Date

2/24 1920

Pyle

Scout

Map No. K 11 Sec. 13 Twp. 29 R. 5Well No. 2 FoxMandy Lee Oil Company

Contractor

SECTION PLAT

200 Ft. from N. Line

Ft. from S. Line

1120 Ft. from E. Line

Ft. from W. Line

			φ

COMPLETED

Location

Rig up

Drilling and Remarks:

RECORD

Cased _____ in., _____ ft.

Sand _____

Gas _____

Oil _____

Total Depth _____

PRODUCTION

1st 24 hrs. Nat. _____

1st 24 hrs. after shot _____

Gas _____ Cu. Ft.

Dry Hole 2870

Abandoned _____

Date

Pyle

9/12 19120

Scout