

Sumner

DX 78-1

KANSAS

Section 36 Township 34 Range 2E

Well No. #14 Airport

Company McNeish & Gralapp

NORTH

10

WEST

EAST

0

SOUTH

Sumner

KANSAS

SEC.	TWP.	R.
36	34	2 E

WELL NO.

14 Airport

FARM

COMPANY

McNeish & Gralapp

CONTRACTOR

Smitherman

Hilltop Pool


990 Ft. from N. Line

Ft. from S. Line

Ft. from E. Line

990 Ft. from W. Line

SE NW SE

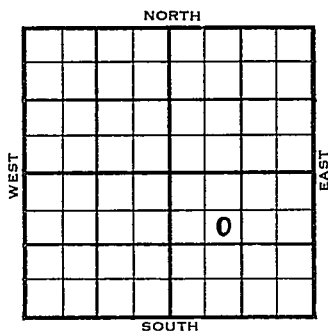

1955

ELEVATION

1216'

REPORT

3/9

RUR

4/20

Spud 3-13-55 Oil well TD 3538


8" @ 120 Layton 2807 KC 2987

Oswego 3201 Bart 3500 TD 3538

5" @ 3537 24/3501-15 F/30 BOPH

Comp. 25 BOPD

COMPLETED

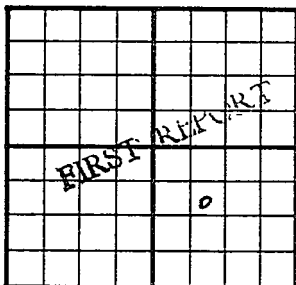County Sumner State KansasSec. 36 (Blk. Twp.) 34 (Sur. Rge.) 2E Map No.Operator McNeish & GralappWell No. 14 Farm AirportElev. Location SE NW SE990 Ft. From N Line SE990 Ft. From W Line Quarter1st. Report MAR 9 1955

Completion

Remarks

Smitherman - Contr.

Spudding Date

Drlg. Data Hilltop PoolR U R

FABEN GILSTRAP



Comp. 25 bopd

FABEN GILSTRAP.