


Map No. _____ Sec. 13 Twp. 29 R. 5
 Well No. 6 Fox Farm _____
Acres Company _____

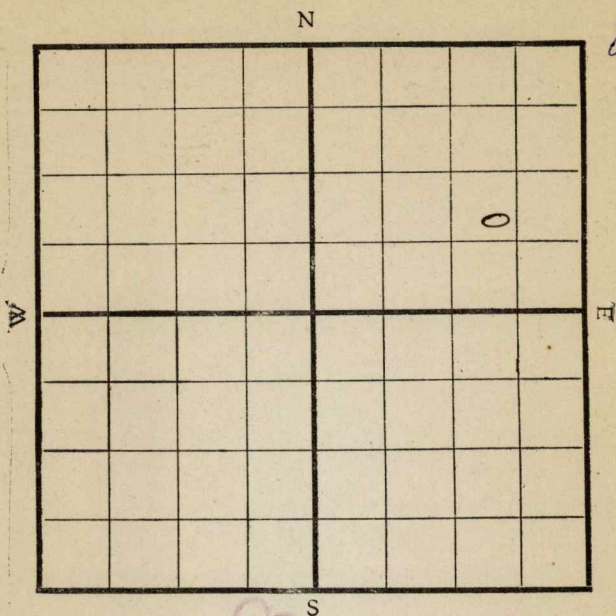

Location _____

Rig Up _____

Drilling Remarks:

Drilling Remarks:

RECORD

PRODUCTION

Cased _____ in. _____ ft.

1st 24 hrs. Nat. _____

Sand _____

1st 24 hrs. after shot _____

Gas _____

Gas _____ cu. ft.

Oil _____

Dry Hole _____

Total Depth _____


Abandoned _____

Map No. _____ Sec. 13 Twp. 29 R. 5Well No. 6 Fox Farm _____S & S Oil Company _____

_____ Ft. from N. Line

990 Ft. from S. Line990 Ft. from E. Line

_____ Ft. from W. Line

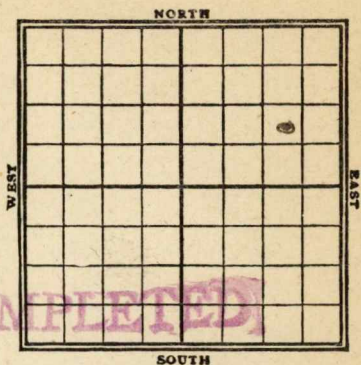1950
DateREPORT **FIRST REPORT**

7/10	To Y.
24	ccc
3/13	Tools
23	Dry 750'
4/2	- 950
9	✓ 1475
5/4	✓ 2350
6/8	Dlg. @ 2860 (Ligne show)
7/11	Sd 2860
24	Sd. ✓
8/4	Dry 3400'
8/10	Dlg @ 3430'
8/25	S. & S. Oil Co.
	Dry 3430'

Map No. 1511 Sec. 13 Twp. 29 R. 5Well No. 6 FordS. H. Oil Company

Contractor

SECTION PLAT

			0

Ft. from N. Line

990 Ft. from S. Line990 Ft. from E. Line

Ft. from W. Line

FIRST REPORT

Location

Rig up

Drilling and Remarks:

J. O. G.

RECORD

Cased _____ in., _____ ft.

Sand _____

Gas _____

Oil _____

Total Depth _____

PRODUCTION

1st 24 hrs. Nat. _____

1st 24 hrs. after shot _____

Gas _____ Cu. Ft.

Dry Hole _____

Abandoned _____

Date

7/10 19120

Pyle

Scout

Map No. K11 Sec. 13 Twp. 29 R. 5Well No. 6 FoxS. H. O. & S. Company

Contractor

SECTION PLAT

Ft. from N. Line

990 Ft. from S. Line990 Ft. from E. Line

Ft. from W. Line

			φ

COMPLETED

Location

Rig up

Drilling and Remarks:

RECORD

Cased _____ in., _____ ft.

Sand _____

Gas _____

Oil _____

Total Depth _____

PRODUCTION

1st 24 hrs. Nat. _____

1st 24 hrs. after shot _____

Gas _____ Cu. Ft.

Dry Hole 3430

Abandoned _____

Date

8/25 19120

Pyle

Scout