

Sumner

KANSAS

SECTION 36 TOWNSHIP 34 RANGE 2 E

WELL NO. #21 Airport

COMPANY McNeish & Gralapp

NORTH

14

							0

SOUTH

Sumner

KANSAS

SEC. 36	TWP. 34	R. 2E
------------	------------	----------

WELL NO.

#21 Airport

FARM

COMPANY

McNeish & Gralapp

CONTRACTOR

Watson

Hilltop


\_\_\_\_\_ Ft. from N. Line

\_\_\_\_\_ Ft. from S. Line

\_\_\_\_\_ Ft. from E. Line

\_\_\_\_\_ Ft. from W. Line

~~SE SE SE~~ SE SE SE

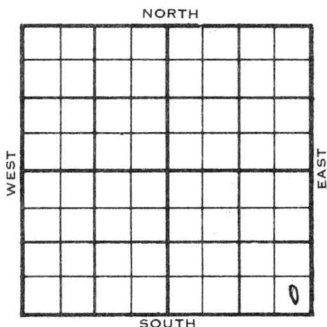

1956	ELEVATION 1214	REPORT
------	-------------------	--------

1-11

8" @ 80

2-8

MIRT

Comm. 1-17-56

5 1/2" @ 3534

CO 3522

PB 20/3495-3500, 28/3503-11

Flwd est 40 BOPH no/wtr. 4 hrs.

Est Flw 25 BOPD no/wtr.

Stal 2360

Lay 2801

KC 2980

OSW 3189

Bart1 3489

TD 3535'

COMPLETED

County Sumner Elev. \_\_\_\_\_  
 Sec. 36 Twp. 34 Rge. 2E  
 Company McNeish & Gralapp  
 Farm Name Airport No. 21

TOPS	DEPTH	LOG	DATUM	Loc. in Sec.
Anh.				SE SE SE
Tr.				
H.				
Dg.				
Bl.				
L.				Geol. _____
K.C.				Contr. _____
B.K.C.				<u>Watson</u>
Ce.				Pool _____
C.				<u>Hilltop</u>
M.				
M.				
K.				
Mz.				
Me.				
V.				
S.				
S.				
A.				
R.				
Pe.				
G.				
T.D.				

JAN 11 1956  
 FIRST REPORT

Date Comm. 8" @ 80

\_\_\_\_\_

\_\_\_\_\_

\_\_\_\_\_

\_\_\_\_\_

\_\_\_\_\_

\_\_\_\_\_

\_\_\_\_\_

\_\_\_\_\_

\_\_\_\_\_

Co.  
Lse.  
No.  
Sec.  
T.  
R.

County Summer Elev. 1214  
 Sec. 36 Twp. 34 Rge. 2E  
 Company McNeish & Gralapp  
 Farm Name Airport No. 21

TOPS	DEPTH	LOG	DATUM	Loc. in Sec.
Ank.				SE SE SE
Tp. <u>Stall</u>	<u>2260</u>		<u>1146</u>	
H. <u>Log</u>	<u>2801</u>		<u>1587</u>	
Tr.				
Dg.				
Bl.				
L.				
K.C. <u>2980</u>			<u>1766</u>	Geol.
B.K.C. <u>OSW</u>	<u>3189</u>		<u>1975</u>	Contr.
Ce. <u>Bartl</u>	<u>3489</u>		<u>2275</u>	<u>Watson</u>
C.				
M.				
M.				Pool
K.				<u>Hilltop</u>
Mz.				
Ma.				
V.				
S.				
S.				
A.				
R.				
PE.				
G.				
TD	<u>3535</u>			

**COMPLETE**

Date Comm. FEB 8 1956  
8" @ 80 JAN 18 '56 MIRT FEB 8 1956

-56 2700 FEB 1 '56 5 1/2 3534/  
FEB 8 '56 CO 3522 PBTD 20/3495  
-3500 28/3503-11 Flwd est  
40 3000 no/w 4wa  
est Flw 25 3000 no/w to