

Barton

KANSAS

Section 8 Township 16 Range 14W

Well No. #1 Karst

Company Raymond Gear

NORTH

			0				

WEST

EAST

SOUTH

Barton

KANSAS

Sec. 8 Twp. 16 R. 14WV

Well No. #1 Karst Farm _____

Raymond Gear Company _____

Wildcat Contractor _____


330' Ft. from N. Line

_____ Ft. from S. Line

330' Ft. from E. Line

_____ Ft. from W. Line

NE NE NW

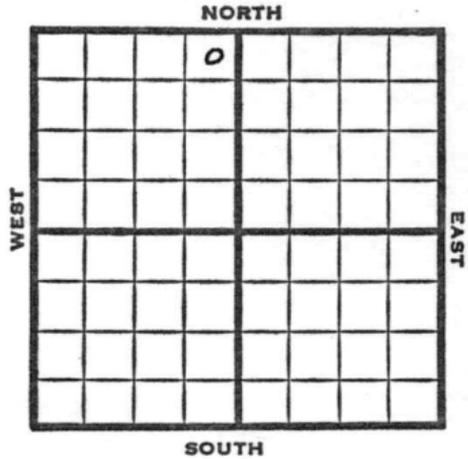

1951 Elev. 1926' REPORT

5/29 Spud 5-25-51
8" @ 151
Anhy 910
Drlg. 1820'

6/5 Spud 5-25-51
D&A TD 3422
8" @ 151
Anhy 910 Br Lime 3140
Dodge 3097 Doug 3111
Heeb. 3078 KC 3151
Arb. 3397 Cong. 3382
TD 3422
DST 3163-70 opn 30 min
Rec. 15' socm SSO 3320-25
DST 3318-25 opn 30 min.
Rec. 25' mud
DST 3398-3405 opn 30 min.
Rec. 12' mud D&A

ABANDONED

County **Barton** State **Kansas**

Sec. **8** (Blk. Twp.) **16** (Sur. Rge.) **14W** Map No.

Operator **Raymond Gear**

Well No. **1** Farm **Karst**

Elev. **1926** Location **NE NE NW**

			0		

FIRST REPORT

330 Ft. From **N** Line **NW**

330 Ft. From **E** Line **Quarter**

Ist. Report **MAY 29 1951**

Completion

Remarks

Spudding Date **5-25-51**

Drlg. Data **Wildcat**

8" @ 151 Anhy 910 drlg. 1820

J. E. TYRA

County Barton State Kansas

Sec. 8 (Blk.) 16 (Sur.) 14W Map No.

Operator Raymond Gear

Well No. 1 Farm Karst

Elev. 1926 Location NE NE NW



330 Ft. From N Line NW

330 Ft. From E Line Quarter

1st. Report

Completion JUN 6 1951

Remarks Wildcat

Spudding Date 5-25-51

Drlg. Data D & A TD 3422

8" @ 151 Anhy 910 Br. lime 3140

Dodge 3097 Doug. 3111 Heeb. 3078

KC 3151 Arb. 3397 Cong. 3382 TD 3422

DST 3163-70 open 30 min. Rec. 15' socm

SSO 3320-25 DST 3318-25 open 30 min.

Rec. 25' mud DST 3395-3405 open 30 min.

Rec. 12' mud D & A

J. E. TYRA