
Barton KANSAS

SECTION 9 TOWNSHIP 16 RANGE ~~11W~~ 14W

WELL NO. #1 Karst "B"

COMPANY Rudy Herman

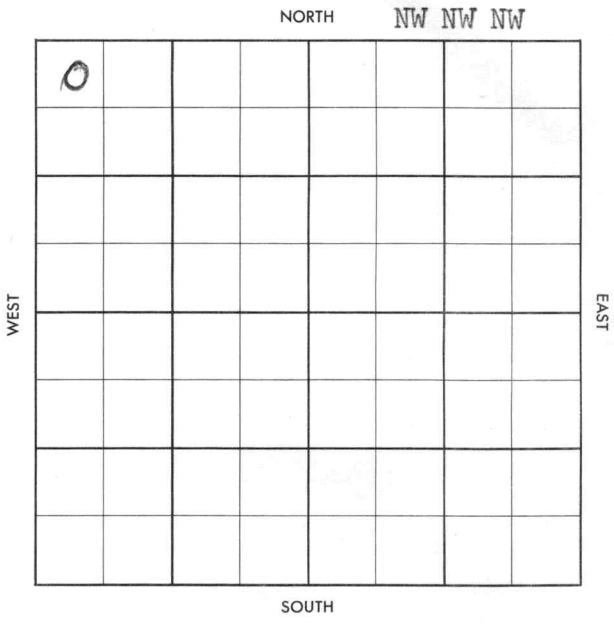

FORM 504-3 SUNRAY

FORM 513 SUNRAY

County Barton Elev.

Sec. 9 Twp. 16 Rge. 11W

Company Rudy Herman

Farm Name Karst "B" No. 1

TOPS	DEPTH	LOG	DATUM
Anh.			
Tp.			
H.			
Tr.			
Dg.			
B.L.			
L.			
K.C.			
B.K.C.			
Ce.			
C.			
M.			
M.			
K.			
Mz.			
Mo.			
V.			
S.			
S.			
A			
R.			
P€.			
G.			
T.D.			

Loc. in Sec. NW NW NW

Geol.

Contr.

Pool Nuss

O

FIRST REPORT

AUG 14 '57

Date Comm.

Location

13

Co. Lse. No. Sec. T. R.

FORM 513 SUNRAY

CORRECTION

County Barton Elev.

Sec. 9 Twp. 16 Rge. 14W

Company Rudy Herman

Farm Name Karst "B" No. 1

TOPS	DEPTH	LOG	DATUM
Anh.	925		
Tp.	2866		
H.	3097		
Tr.	3119		
Dg.			
Bl.			
L.	3162		
K.C.			
B.K.C.			
Ce.			
C.			
M.			
M.			
K.			
Mz.			
Mg.			
V.			
S.			
S.			
A	3398		
R.			
P€.			
G.			
T.D.	3472		

Loc. in Sec. NW NW NW

Geol.

Contr.

Pool Nuss



Date Comm.

Location AUG 21 '57 ~ AUG 28 '57 SEP 4 '57 SEP 11 '57
SEP 18 '57 9-9-57 8 5/8 315
lp 3120 SEP 25 '57 OCT 2 '57 DST
3393 - 3412 1hr 6' m BHP 0
DST 3408 - 22 30" 7' m BHP
680/20" DST 3420 - 32 1hr
22' m+w BHP 945/20"
no log D & A

Co. Lse. No. Sec. T. R.