


SECTION 10 TOWNSHIP 16 RANGE 14W

WELL NO. #1 Heimann

COMPANY Shelly - Miller

NORTH

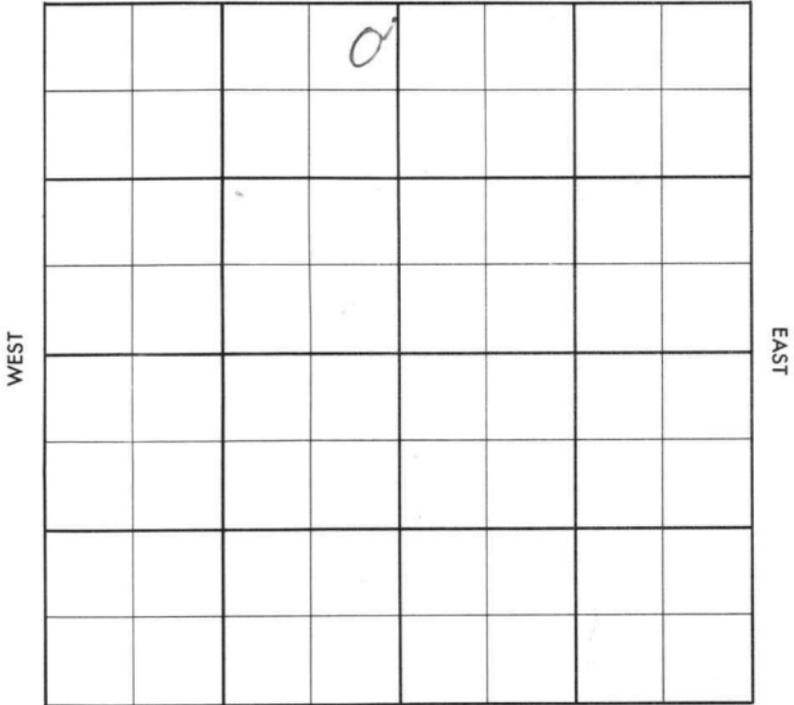

SOUTH

WEST

EAST

Barton

KANSAS

SEC.

10

TWP.

16

R.

14W

WELL NO.

#1 Reimann

FARM

COMPANY

Shelly-Miller

CONTRACTOR

Co. Tools

WILDCAT


FT. FROM N. LINE

FT. FROM S. LINE

FT. FROM E. LINE

FT. FROM W. LINE

NE NE NW

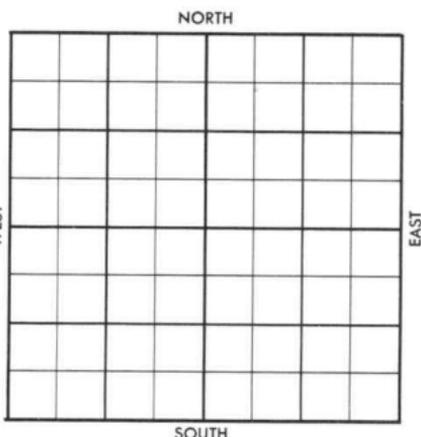

Skelly-DHM, Mid-States-DHM

1956

ELEVATION

1910'

REPORT

5-23

Comm. 5-8-56

8 5/8" @ 326 w/225

DST 3153-3210 op 30 min, rec. 30' mud, BHP 670#.

DST 3290-3330 op 30 min, rec. 8' mud, BHP 50#.

DST 3348-60 op 30 min. rec. 10' mud, BHP 0#.

DST 3350-70 op 30 min, rec. 10' mud, BHP 60#.

D & A

H. 3065'; BL. 3128'; L. 3148'; A. 3353

Log tops:

H. 3061'; Tr. 3078'; Dg. 3094';

BL. 3130'; L. 3149'; A. 3351';

TD 3403'

FIRST REPORT

ABANDONED

County Barton Elev. _____
 Sec. 10 Twp. 16 Rgs. 11W
 Company Shelly-Miller
 Farm Name Reimann No. 1

TOPS	DEPTH	LOG	DATUM
Anh.			
Tp.			
H.			
Tr.			
Dg.			
Bl.			
L.			
K.C.			
B.K.C.			
Ce.			
C.			
M.			
M.			
K.			
Mz.			
Me.			
V.			
S.			
S.			
A.			
R.			
PE.			
G.			
T.D.			

Loc. in Sec. NE NE NW

Geol. _____
 Contr. Co. tools

Pool Wildcat

	0	

FIRST REPORT
 MAY 9 '58

Date Comm. Mid-States DHM
M I R

MAY 1 1958

R.G.

[Handwritten signature]

Co.

Use.

No.

Sec.

T.

R.

County Barton Elev. 1910
 Sec. 10 Twp. 16 Rge. 11W
 Company Shelly-Miller
 Farm Name Reinam No. 1

Co.

TOPS	DEPTH	LOG	DATUM
Anh.			
Tp.			
H.	3065	3061	
Tr.		3078	
Dg.		3094	
Bl.	3128	3130	
L.	3148	3149	
K.C.			
B.K.C.			
Ce.			
C.			
M.			
M.			
K.			
Mz.			
Me.			
V.			
S.			
S.			
A.	3353	3351	
R.			
PE.			
G.			
TD.	3403		

Loc. in Sec. NE NE NW

Geol. _____

Contr. _____

Co. tools _____

Pool _____

Wildcat _____

FIRST REPORT
 ABANDONED
 MAY 23 1956

Sec.

No.

Sec.

T.

R.

Date Comm. Skelly DHM Mid-States DHM
M I R MAY 16 '56 5-8-56 878 326
1225 ID 3105 MAY 23 '56 DST 3153
-3210 30" rec 30' Md BHP 670
DST 3290-3330 30" rec 8' Md
BHP 50# DST 3348-60 30" rec
10' Md BHP 0 DST 3350-70 30"
rec 10' Md BHP 60#
D&Q