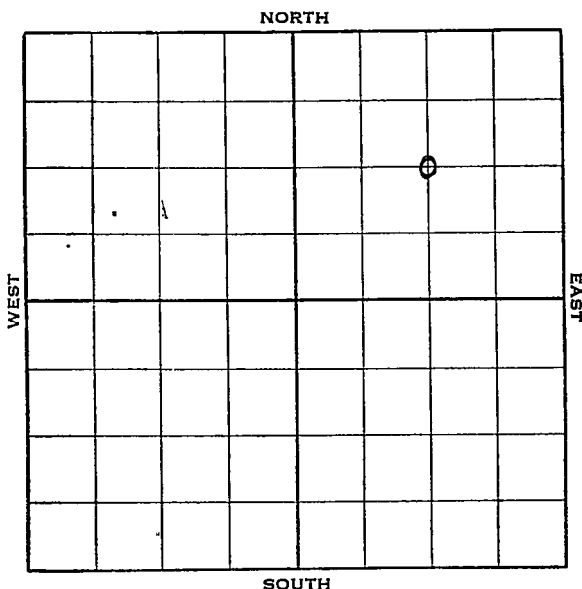


KANSAS

Barton

Section 11 Township 16 Range 14-WWell No. 2 Bitter "A"Company Shell

KANSAS

Barton


Sec. 11 Twp. 16 R. 14-WWell No. #2 Bitter "A" FarmShell Company1320 Ft. from N. Line

Ft. from S. Line

1320 Ft. from E. Line

Ft. from W. Line

Elev. 1920

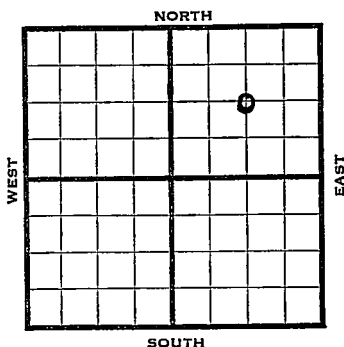

1938	REPORT
5/4	Drlg. 623'.
5/12	7" @ 670'. Anhy 889'.
	Drlg. 1725'.
5/20	Fort Riley 1885'. Neva 2238'.
	Drlg. 2873'.
5/27	Lans. 3159'. Drlg. 3350'.
6/3	Arb. 3352-64' T.D. S.O.
	4" @ 3353'. RUST.
6/10	Drilled plug. 650' oil in 4 hrs.
	1000 acid. Swab 57 oil in 8
	hrs. 3000 acid. Swab 1-1/3
	oil per hour.
	Deepened to T.D. 3373'.
	Swab 31 oil in 15 hrs.
6/17	TD 3373' Shot 15 qts.
	3365-70' 1000' Fluid
	Swb 26 oil - 6 hrs.
6/24	4000 acid. Swab 31 oil in 6 hrs.
7/1	P.B. 3370'
7/8	" "
7/15	" "

OVER

1938

7/22 P. B. 3370'.

7/27 4" - 3353'.

Arb. 3352'.

T. D. 3373'.

4000 acid.

P. B. 3370'.

15 bbls. minimum well.

COMPLETED

Barton KANSAS


Map No. 73 Sec. 11 Twp. 16 R. 14WWell No. 2 Bitter "A"Shell

Company

Contractor

FIRST REPORT

SECTION PLAT

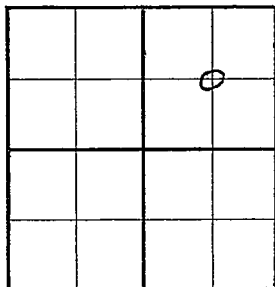1320 ^{C NE} Ft. from N. Line Ft. from S. Line1320 Ft. from E. Line Ft. from W. LineLocation Rig up

Drilling and Remarks:

Drlg. 623

RECORD

Cased in., ft.Sand Gas Oil Total Depth

PRODUCTION

1st 24 hrs. Nat. 1st 24 hrs. after shot Gas Cu. Ft.Dry Hole Abandoned

Date

MAY 4 - 1938 19 H. D. Hatfield Scout

Map No. 72 Sec. 11 Twp. 16 R. 14WWell No. 2 Bitter "A"Shell

Company

Contractor

COMPLETED

C NE


1320 Ft. from N. Line

Ft. from S. Line

1320 Ft. from E. Line

Ft. from W. Line

SECTION PLAT

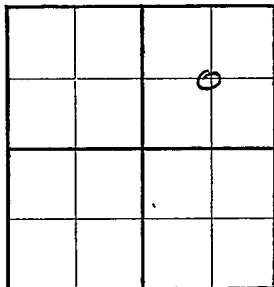

Location _____

Rig up _____

Drilling and Remarks:

*4000 and
PB 3370*

15 - MIN - well

RECORD

Cased 4 in., 3353 ft.Sand 456 3352

Gas _____

Oil _____

Total Depth 3373

PRODUCTION

1st 24 hrs. Nat. _____

1st 24 hrs. after shot _____

Gas _____ Cu. Ft.

Dry Hole _____

Abandoned _____

Date

JUL 27 1938 19

H. D. Hatfield

Scout