


KANSAS

Barton county

Section 11 Township 16 Range 14-W

Well No. #1, Bitter

Company Hinkle and Franco Central

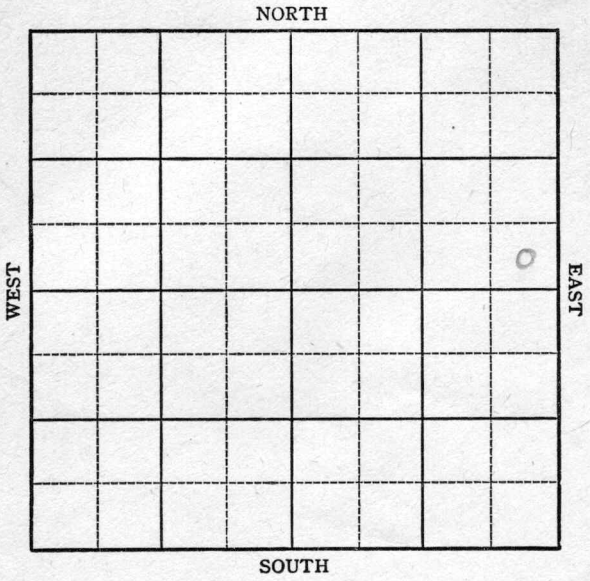

KANSAS

Barton county

Sec. 11 Twp. 16 R. 14-W

Well No. #1, Bitter Farm

Hinkle and France Central Company


Susank Pool

Ft. from N. Line

330' Ft. from S. Line

330' Ft. from E. Line

Ft. from W. Line

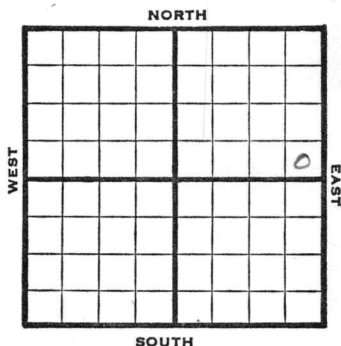

SE NE

1946	Elev. 1917 REPORT
12/4	8" @ 161' Drlg. 1000'.
12/10	Drlg 2829'
12/17	Arb 3344-48 TD 5" @ 3345, RUST
1947	
1/4	Swb 2½ oil PH, 1000 acid
1/8	Lans 3140' Pump 35 oil in 6 hrs.
1/15	" " "
1/21	" " "
2/5	TD 3348' Arb 3344 5" @ 3345 1000 Acid Pump 15 Pot. Grav. 39
	COMPLETED

Map No. 73 Sec. 11 Twp. 16 R. 14W

Well No. 1 Bitter

Hinkle & Franco Central Company

FIRST REPORT Contractor

SE NE


SECTION PLAT

 Ft. from N. Line

330 Ft. from S. Line

330 Ft. from E. Line

 Ft. from W. Line

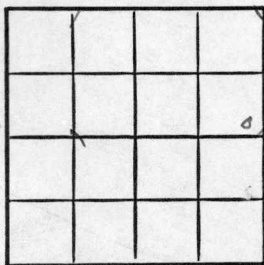

Barton County

Location

Rig up

Drilling and Remarks:

8" @ 161

drlg. 1000

RECORD

Cased in., ft.

Sand

Gas

Oil

Total Depth

PRODUCTION

1st 24 hrs. Nat.

1st 24 hrs. after shot

Gas Cu. Ft.

Dry Hole

Abandoned

Date

DEC 4 1946

19

S. J. LEWIS

Scout


Map No. 73 Sec. 11 Twp. 16 R. 14W

Well No. 1 Bitter

Hinkle & Franco Central Company
COMPLETE

SE NE Contractor

E11910
SECTION PLAT

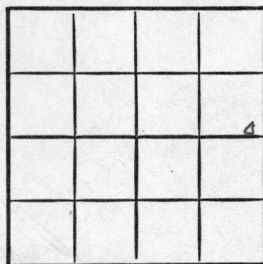

 Ft. from N. Line

330 Ft. from S. Line

330 Ft. from E. Line

 Ft. from W. Line

Barton County

Location

Rig up

Drilling and Remarks:

Cr 83344
5" @ 3345
1000 acid
Pump 15 Pst
390 gr

RECORD

Cased in., ft.

Sand

Gas

Oil

Total Depth 2348

PRODUCTION

1st 24 hrs. Nat.

1st 24 hrs. after shot

Gas Cu. Ft.

Dry Hole

Abandoned

Date

FEB 5 1947 19

S. J. LEWIS Scout