

Barton


KANSAS

FORM 51 SM 2-38 TPCO.

Section 11 Township 16 Range 14-W

Well No. 1 Bitter "A"

Company Shell

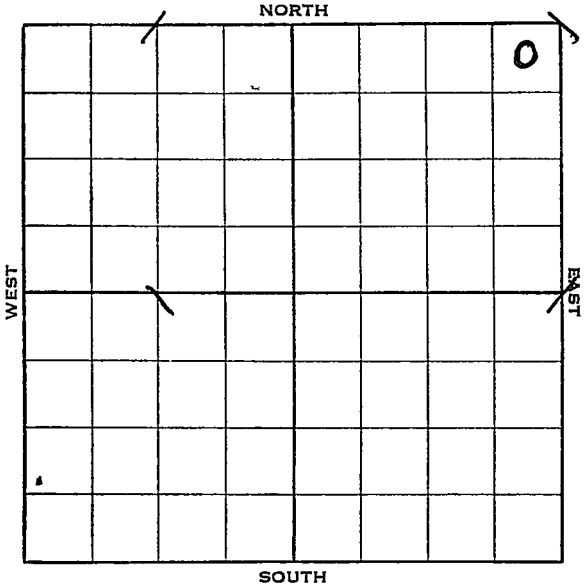

Sec. 11 Twp. 16 R. 14-W

Well No. #1 Bitter "A" Farm _____


Shell Company _____

330 Ft. from N. Line

_____ Ft. from S. Line

330 Ft. from E. Line

_____ Ft. from W. Line

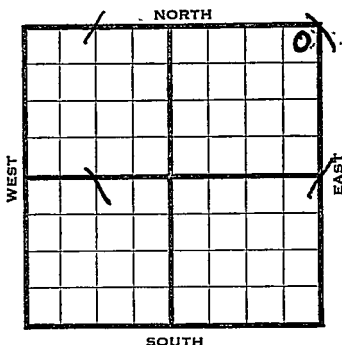

1938	REPORT
4/6	7" @ 645'.
	Drlg. 2320'.
4/15	Topeka 2808'. K.C. 3119'.
	Drlg. 3315'.
4/22	Arb. 3323'.
	Spotted stains 3324-29'.
	4" @ 3326'. Drlg. 3364'.
4/29	T.D. 3376'. 100' water.
	S.D.O.
5/4	4" @ 3326'.
	Arb. 3323'.
	T.D. 3376'.
	ABANDONED

Map No. 73 Sec. 11 Twp. 16 R. 14W

Well No. I Bitter "A"

Shell Company

Contractor

FIRST REPORT

SECTION PLAT

NE/C

330 Ft. from N. Line

_____ Ft. from S. Line

330 Ft. from E. Line

_____ Ft. from W. Line

			0

Location _____

Rig up _____

Drilling and Remarks:

7" 645

Drlg. 2320

RECORD

Cased _____ in., _____ ft.

Sand _____

Gas _____

Oil _____

Total Depth _____

PRODUCTION

1st 24 hrs. Nat. _____

1st 24 hrs. after shot _____

Gas _____ Cu. Ft.

Dry Hole _____

Abandoned _____

Date

APR 6 - 1938 19

H. D. Hatfield Scout

Map No. 73 Sec. 11 Twp. 16 R. 14W

Well No. 1 Bitter "A"

Shell

Company

Contractor

ABANDONED

NE/C

330 Ft. from N. Line

_____ Ft. from S. Line

330 Ft. from E. Line

_____ Ft. from W. Line

SECTION PLAT

			0

Location _____

Rig up _____

Drilling and Remarks:

DVA

RECORD

Cased 4 in., 3326 ft.

Sand Arb 3323

Gas _____

Oil _____

Total Depth 3376

PRODUCTION

1st 24 hrs. Nat. _____

1st 24 hrs. after shot _____

Gas _____ Cu. Ft.

Dry Hole _____

Abandoned _____

Date

MAY 4 - 1938 19

H. D. Hatfield

Scout