

# KANSAS


Barton

Form 51-5M-7-39-Palace

Section 11 Township 16 Range 14W

Well No. #1 Karst

Company A.G.Kaiser

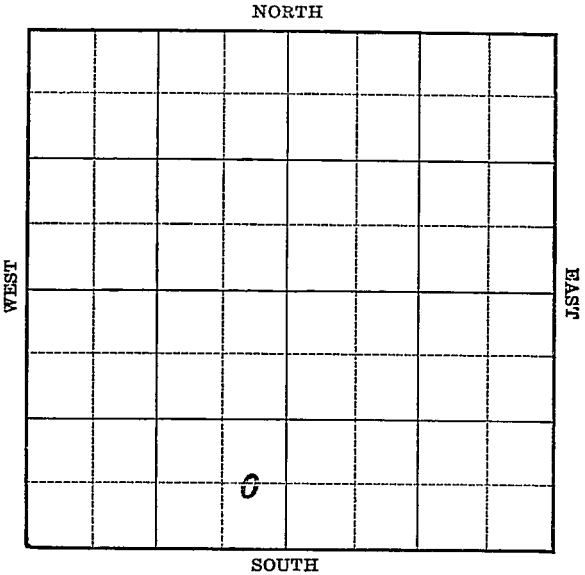

Sec. 11 Twp. 16 R. 14-W

Well No. #1 Karst Farm

A. G. Kaiser Company

(Trapp)


\_\_\_\_\_ Ft. from N. Line

660 Ft. from S. Line

330 Ft. from E. Line

\_\_\_\_\_ Ft. from W. Line

Elev. 1923

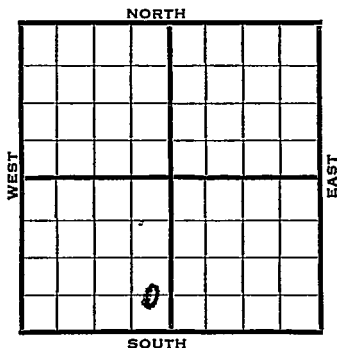

1940	REPORT
7/10	S. H.
7/18	8" - 132' Anhy 893'
	Drlg. 2060'
7/25	Topeka 2823' Lans. 3148'
	Drlg. 3319'
8/2	Arb. 3373' S.S.O. 3374-75'
	5" - 3374' Drlg. 3381'
8/8	T.D. 3396' 10000 oil.
	200' water 4 days.
8/14	1000 acid. Pump 9 bbls oil per hr
	Lots of water.
8/22	" " "
8/29	" " "
9/5	" " "
9/12	" " "
9/19	" " "
9/26	" " "
10/3	" " "
10/10	36 shots 3214-20'
10/17	" " "
10/24	" " "
10/31	Shut down. OVER

1940

11/7 36 shots 3214-20'

Shut down.

11/14 " "

11/21 " "

11/27 " "

12/5 " "

12/11 Arb. 3373'

5" - 3374'

T.D. 3396'

Water.

ABANDONED

Map No. \_\_\_\_\_ Sec. 11 Twp. 16 R. 14W

Well No. 1 Karst

A. G. Kaiser Company

Contractor

**FIRST REPORT**

**SECTION PLAT**

C E L SE SW

\_\_\_\_\_ Ft. from N. Line

660 Ft. from S. Line

330 Ft. from E. Line

\_\_\_\_\_ Ft. from W. Line


Trapp Pool

Location \_\_\_\_\_

Rig up \_\_\_\_\_

Drilling and Remarks:

S.H.

**RECORD**

Cased \_\_\_\_\_ in., \_\_\_\_\_ ft.

Sand \_\_\_\_\_

Gas \_\_\_\_\_

Oil \_\_\_\_\_

Total Depth \_\_\_\_\_

**PRODUCTION**

1st 24 hrs. Nat. \_\_\_\_\_

1st 24 hrs. after shot \_\_\_\_\_

Gas \_\_\_\_\_ Cu. Ft.

Dry Hole \_\_\_\_\_

Abandoned \_\_\_\_\_

Date

III 10 1940 19

S. I. LEWIS Scout

Map No. 73 Sec. 11 Twp. 16 R. 14WWell No. 1 KarstA. G. Kaiser

Company

Contractor

ABANDONED

C E L S E S W

         Ft. from N. Line660 Ft. from S. Line330 Ft. from E. Line         Ft. from W. Line

TRAPP POOL

## SECTION PLAT


Location                                 Rig up                                 

Drilling and Remarks:

*Oil & 3373**5" @ 3374**Water.*

## RECORD

Cased          in.,          ft.Sand                                 Gas                                 Oil                                 Total Depth 3396

## PRODUCTION

1st 24 hrs. Nat.                                 1st 24 hrs. after shot                                 Gas                                  Cu. Ft.Dry Hole                                 Abandoned                                 

Date

DEC 11 1940 19S. J. LEWIS

Scout