

Section 18 Township 14 Range 13 W

Well No. # 1 Shaffer

Company Sterns Oil

NORTH

2

WEST

EAST

				0			

SOUTH

Sec. 18 Twp. 14 R. 13W

Well No. #1 Shaffer Farm

Sterns Oil Company

Contractor

Hall-Burney Pool


990 Ft. from N. Line

Ft. from S. Line

Ft. from E. Line

330 Ft. from W. Line

SW NW NE

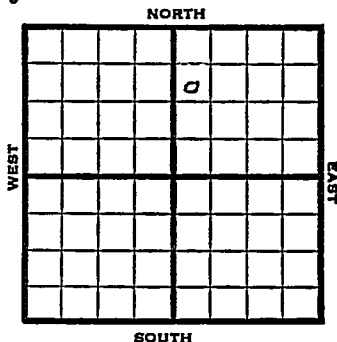

1952 Elev. 1828 REPORT

10/8 Spud 10-1-52  
10" @ 97'  
Anhy 812'  
Drlg. 2046'

10/15 Tarkio 2363  
ETD 2432  
7" @ 2432'

10/22 48/2367-71, SO, Hyd.

10/29 Spud 10-1-52  
Oil well TD 2432' 10" @ 97'  
Anhy 812' Tarkio 2363' TD 2432'  
7" @ 2432 48/2367-71 Hydro.  
Comp. 10 to 15 BOPD

COMPLETED



