


Section 18 Township 14 Range 13 W

Well No. # 7 Shaffer

Company Texas Company

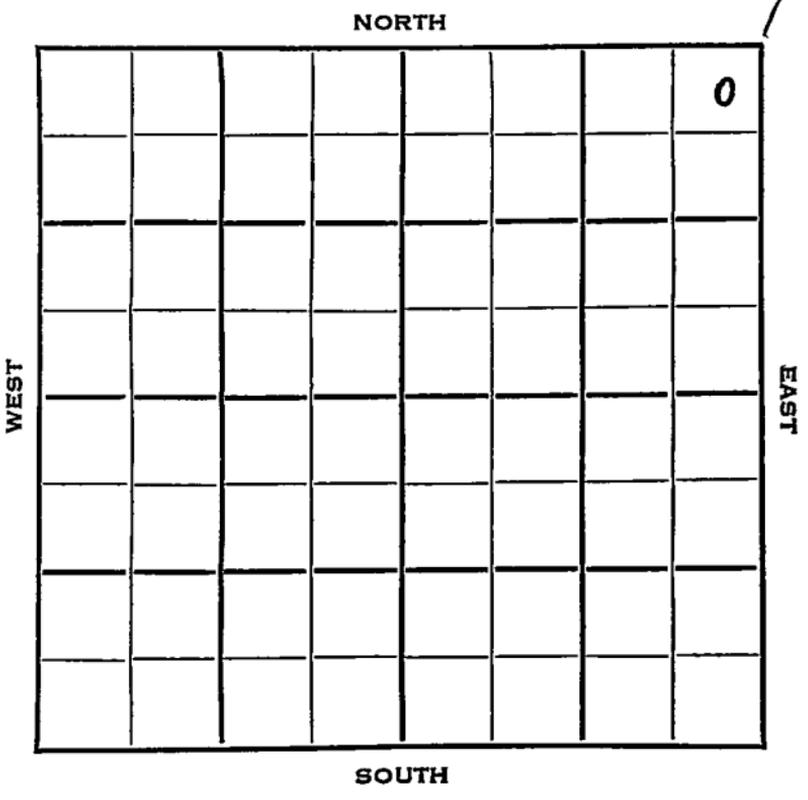

Sec. 18 Twp. 14 R. 13W

Well No. #7 Shaffer Farm

Texas Company Company

Wakefield Contractor

330 Hall-Gurney Pool


Ft. from N. Line

Ft. from S. Line

330 Ft. from E. Line

Ft. from W. Line

NE NE NE

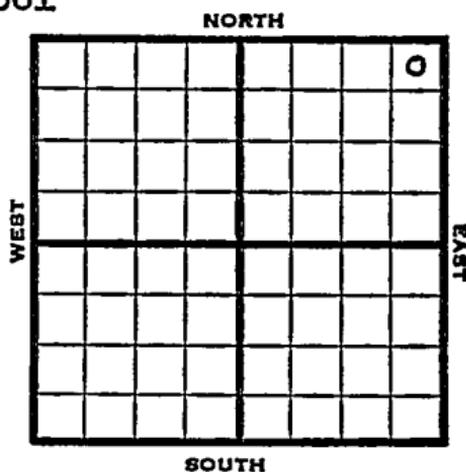

1953 Elev. 1836' REPORT

6/24 Drlg 380'
Spud 6-19-53

7/1 10" @ 816
Drlg. 860'

7/8 Drlg 1875'

7/22 NR

7/29 Spud 6-19-53 D & A TD 2441
10" @ 816 Tarkio 2373 TD 2392
7" @ 2392 DD 2407 5 GW SSO 1 hr.
DD 2413 2 GO 5 GWPH PB 2394
Sd-oil-ffac. S/2 BWPH DD 2441
D & A

ABANDONED

