


Russell

KANSAS

Section 18 Township 14 Range 13-W

Well No. 1 Weimeister

Company Phil-Han Oil

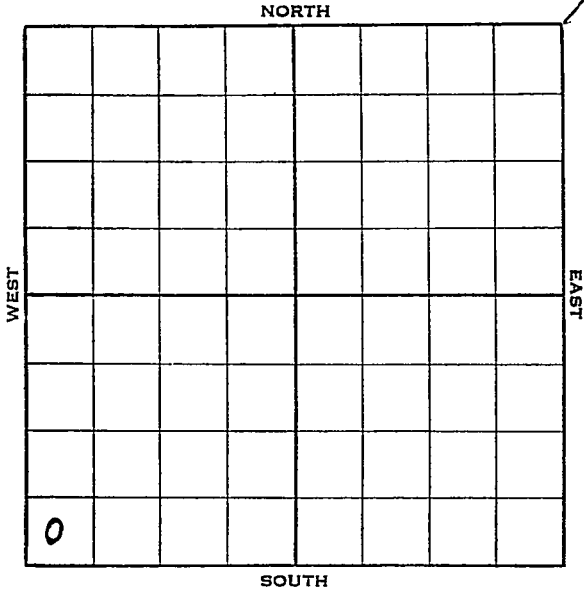

KANSAS

Russell

Sec. 18 Twp. 14 R. 13-W

Well No. #1 Weimeister Farm

Phil-Han Oil Company


_____ Ft. from N. Line

330 Ft. from S. Line

_____ Ft. from E. Line

330 Ft. from W. Line

Elev. 1788

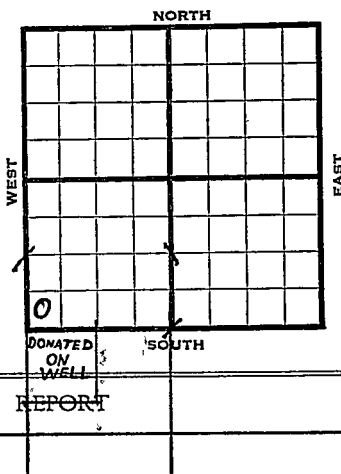

| | |
|-------|--|
| 1938 | |
| 10/12 | Cellar. |
| | Tools & Rig on Ground. |
| 10/17 | Rigging up cable tools (Tel) |
| 10/20 | Spudded (Tel) |
| 10/24 | Dlg. 410 15" 125 (Tel) |
| 10/27 | Dlg. 795 12" 436 10" 753 (Tel) |
| 11/3 | Top Anhy. 747 Fishing bit 1510 (Tel) |
| 11/5 | Dlg. 1800 (Tel) |
| 11/9 | 1 bailer rik free oil per hour show gas 2340-47 Think in Tarkio |
| | 8" 2300 Dlg. 2515 (Tel) |
| 11/15 | T.D. 2815 Hole caving Shut down for 6" casing (Tel) |
| 11/17 | Top Topeka 2640 Show oil 2655-65 Dlg. 2905 lime Expect Lansing this afternoon (Tel) 6"-2815' |
| | Running 6' lower on Topeka than Hartman & Blair #1 producer SE/c 23-14-14W |
| 11/19 | T.D. 2930 sandy shale Hole caving Underreaming 6" (Tel) |
| | OVER |

- 11/21--Top Lansing ~~XXXX 2840~~ ²⁹⁴⁰ T.D. 2965
 No show 6" underreamed to 2963
 Cleaning out (Tel)
- 11/23--Dlg. 3007 No show (Tel)
- 11/28--At 3220 set 64 feet 10 inches of
 5 $\frac{1}{2}$ " liner Now UR liner (Tel)
- 11/29--Top Gorham 3220 Hard sand 3220-23
 Soft sand 3223 At 3225 had 2000 feet
 salt water in 2 hours
 T.D. 3230 in sand May plug back and
 test upper shows (Tel)
- 12/1--Pulled 8" and cemented 6" around 2300
 Had show oil in Tarkio lime 2340-47 (Tel)
- 12/2 Pulled 8" and cemented 6" - 2715
 Will Perf. & test oil shows in
~~TARKIO LIME~~ Topeka & other upper
 shows.
- 12/7--Perforated 79 shots 2643-79
 Acidized 4000 gallons Waiting (Tel)
- 12/8--Swab 1/2 bbl. oil & show water per hour
 after acid Will P.B. to first show
 around 2340 and test (Tel)
- 12/15--P.B. 2350 Ripped pipe 2338-50
 150" oil 1000 acid No help S.D.O.
- 12/15--Will abandon (Tel)
- 12/21 6" - 2963'.
 Gorham 3220'.
 T. D. 3230'.
 H.F.W. 3223-25'.

ABANDONED

Russell KANSAS

Map No. _____ Sec. 18 Twp. 14 R. 13W

Well No. 1 Weimeister

Phil-Han Oil Company

Texas Co. Contractor
Farm out

FIRST REPORT

SECTION PLAT

SW/C

_____ Ft. from N. Line

330 Ft. from S. Line

Special

_____ Ft. from E. Line

330 Ft. from W. Line

| | | | |
|--|--|--|--|
| | | | |
| | | | |
| | | | |
| | | | |

*donated
on
well*

RECORD

Location _____

Cased 17 in. _____ ft.

Rig up _____

Sand _____

Drilling and Remarks:

Gas _____

Cellar

Oil _____

Tools & Rig on

Total Depth _____

Ground

PRODUCTION

1st 24 hrs. Nat. _____

1st 24 hrs. after shot _____

Gas _____ Cu. Ft.

Dry Hole _____

Abandoned _____

Date

OCT 12 1936 19

H. D. Hatfield

Scout

Russell **KANSAS**

Map No. 72 Sec. 18 Twp. 14 R. 13W

Well No. 1 Weimeister

Phil-Han

Company

Contractor

ABANDONED
SW/C

SECTION PLAT

| | | | |
|---|--|--|--|
| | | | |
| | | | |
| | | | |
| 0 | | | |

 Ft. from N. Line

330 Ft. from S. Line

 Ft. from E. Line

330 Ft. from W. Line

WILDCAT

Location

Rig up

Drilling and Remarks:

HFW 3223-25

DYA

RECORD.

Cased 6" in., 2963 ft.

Sand Gorham 3220

Gas

Oil

Total Depth 3230

PRODUCTION

1st 24 hrs. Nat.

1st 24 hrs. after shot

Gas Cu. Ft.

Dry Hole

Abandoned

Date

DEC 21 1938

H. D. Hatfield

19

Scout