

KANSAS


FORM 51 5M 11-44 PETROL

Barton County

Section 12 Township 16 Range 14W

Well No. #1 Hoffman

Company Hinkle and Franco Central

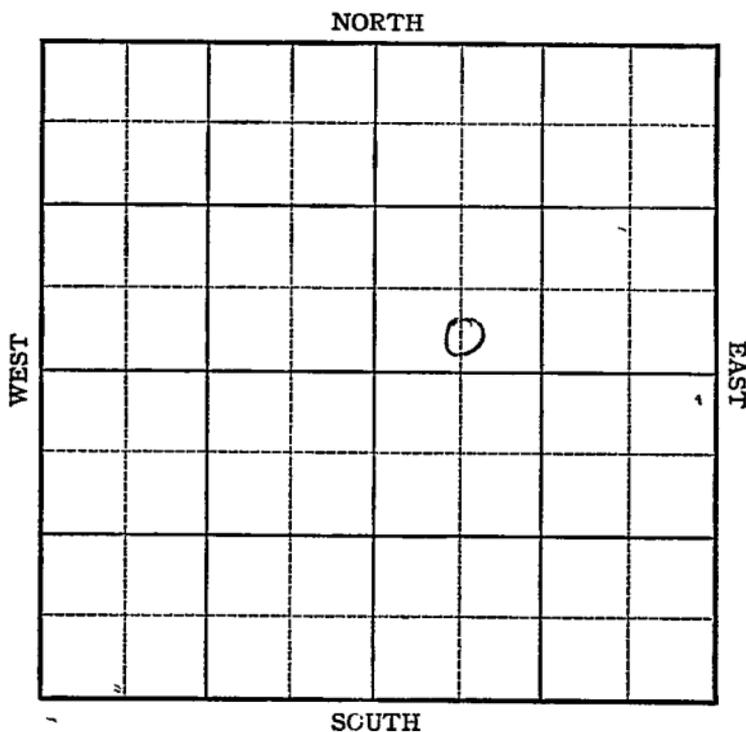

Sec. 12 Twp. 16 R. 14W

Well No. #1 Hoffman Farm

Hinkle and Franco Central Company


Trapp

_____ Ft. from N. Line

330 _____ Ft. from S. Line

_____ Ft. from E. Line

660 _____ Ft. from W. Line

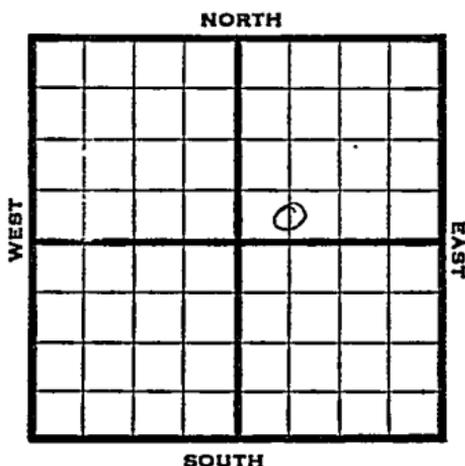

CSL SW NE

1946 Elev. 1884' REPORT

2/13	Location
2/21	R U R
2/28	10" - 160' Anhy 830' Drlg. 1652'
3/7	Lans. 3083' Drlg. 3165'
3/14	Arb. 3302-04' T.D. 7" - 3304'
3/21	1000 acid.
3/28	" "
4/3	Arb. 3302 7" @ 3304 1000 acid. TD 3316 Depth Pot. 1406 Grav. 39.0

COMPLETED

KANSAS KansasPool Name Trapp

Map No. 73 Sec. 12 Twp. 16 R. 14W

Well No. 1 Hoffman

Hinkle and Franco Central Company

FIRST REPORT Contractor

C S L, SW 1/4 NE

SECTION PLAT

_____ Ft. from N. Line

330 Ft. from S. Line

_____ Ft. from E. Line

660 Ft. from W. Line

Barton County

Location X

Rig up _____

Drilling and Remarks:

RECORD

Cased _____ in., _____ ft.

Sand _____

Gas _____

Oil _____

Total Depth _____

PRODUCTION

1st 24 hrs. Nat. _____

1st 24 hrs. after shot _____

Gas _____ Cu. Ft.

Dry Hole _____

Abandoned _____

Date

FEB 13 1946 19

S. J. LEWIS Scout

KANSAS Kansas Pool Name Trapp

Map No. 23 Sec. 12 Twp. 16 R. 14W

Well No. 1 Hoffman

Hinkle & Franco-Central Company

COMPLETED

Contractor

C S L SW NE

E 11884
SECTION PLAT

		o	

Ft. from N. Line

330

Ft. from S. Line

Ft. from E. Line

660

Ft. from W. Line

Barton County

Location _____

Rig up _____

Drilling and Remarks:

CR 3302
7" 3304
1000000
Depth 1406

39 2 2

RECORD

Cased _____ in., _____ ft.

Sand _____

Gas _____

Oil _____

Total Depth 3316

PRODUCTION

1st 24 hrs. Nat. _____

1st 24 hrs. after shot _____

Gas _____ Cu. Ft.

Dry Hole _____

Abandoned _____

Date

APR 3 1946 19

S. J. LEWIS

Scout