


Section 29 Township 16 Range 1 W

Well No. # 1 Karber

Company E. K. Carey

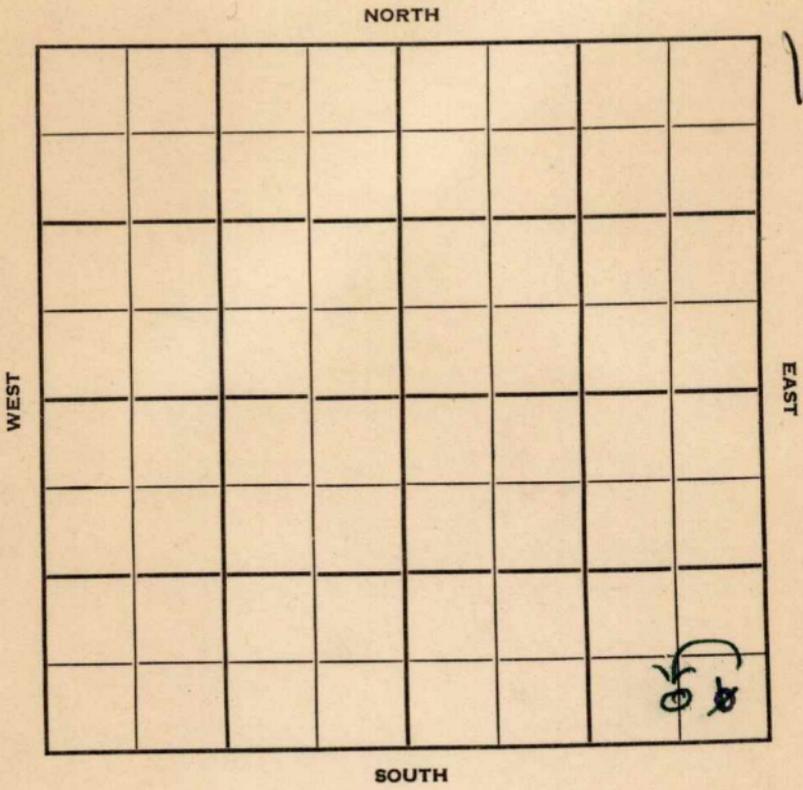



Sec. 29 Twp. 16 R. 1W

Well No. #1 Karber Farm

E. K. Carey Company

Contractor


Ft. from N. Line

330' Ft. from S. Line

~~330'~~
660' Ft. from E. Line

Ft. from W. Line

C S L S E S E
~~SE SE SE~~

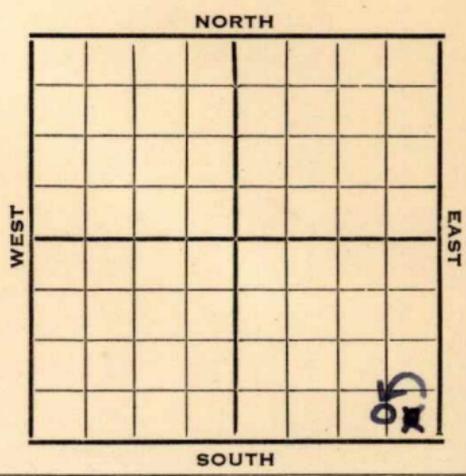

1952 **Elev. 1278'** REPORT

- 9/17 Location
- 9/24 "
- 10/1 "
- 10/8 "
- 10/15 8" @ 119
- 10/22 Drlg. 2568'
- 10/29 **KC 2008' Miss 2615' RTD 2625'**
5" @ 2621'
- 11/5 CO 2625' FU 225' oil & 150' wtr.
40 hrs. 1000 A
- 11/12 Comm. 10-13-52
D & A TD 2660' 8" @ 119
KC 2008' Miss 2615' TD 2625'
5" @ 2621 CO to 2625' FU 225' oil
150' wtr, 40 hr. 1000 A DD 2647
FU 500' wtr. 100' oil
DD 2660' FU 600' wtr. 100' oil
D+A

ABANDONED

Kansas

Map No. _____ Sec. 29 Twp. 16 R. 1W

Well No. 1 Karber

E. K. Carey Company

CORRECTION Contractor

C S L SE SE

SECTION PLAT

			o

_____ Ft. from N. Line

330 Ft. from S. Line

660 Ft. from E. Line

_____ Ft. from W. Line

Saline County

Location _____

Rig up _____

Drilling and Remarks:

Reported
SE SE SE

RECORD

Cased _____ in., _____ ft.

Sand _____

Gas _____

Oil _____

Total Depth _____

PRODUCTION

1st 24 hrs. Nat. _____

1st 24 hrs. after shot _____

Gas _____ Cu. Ft.

Dry Hole _____

Abandoned _____

Date

OCT 15 1952

19

J. G. MCGEHEE

Scout

