

# KANSAS

FORM 51 5M 4-41 PETROL

Russell


Section 19 Township 14 Range 13-W

Well No. #2 Clyde

Company Coralena

NORTH Hall Gurney Pool

13

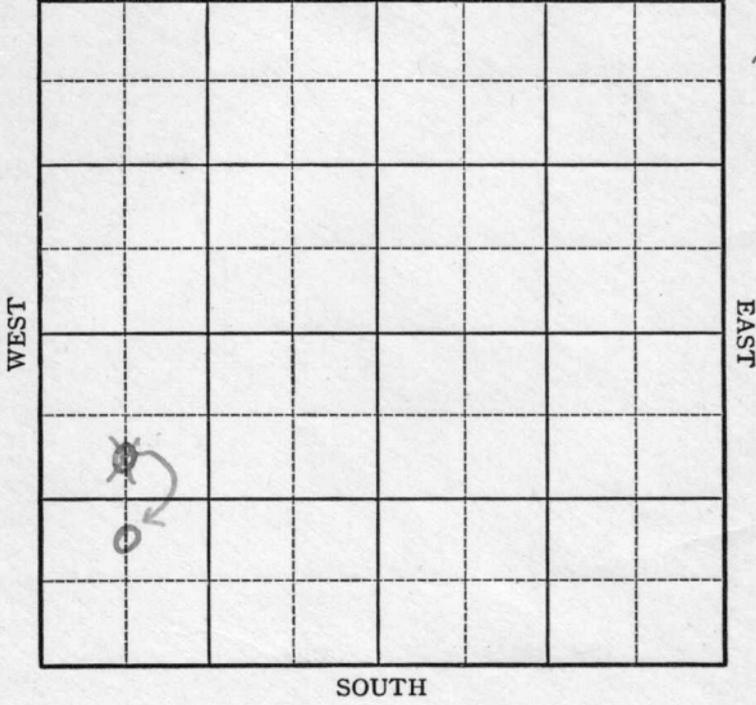

Sec. 19 Twp. 14 R. 13-W

Well No. #2 Clyde Farm

Coralena Company

(Hall Gurney)


~~990~~ Ft. from N. Line

990 Ft. from S. Line

\_\_\_\_\_ Ft. from E. Line

574  
~~660~~ Ft. from W. Line

Elev. 1769

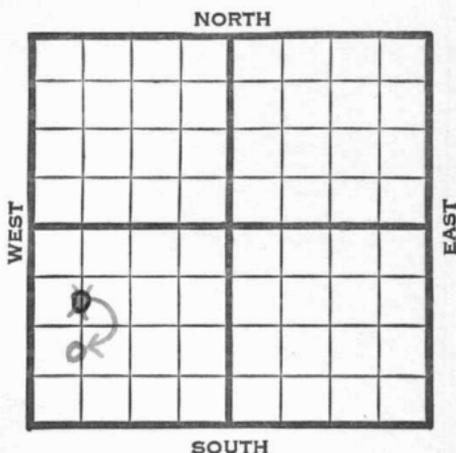

1941	REPORT
4/9	Location
4/18	Rotary rig.
4/24	10" - 240'
	Drlg. 1715'
5/1	Lans. 2907' 5" - 2927'
	T.D. 2942' RUST.
5/8	4000 acid.
5/15	" "
5/22	2000 acid. Testing.
5/28	" " "
6/4	Lans. 2907'
	5" - 2927'
	T.D. 2979'
	6000 acid.
	Potential 48 bbls., pump.
	38.3 Gravity
	COMPLETED

Map No. 72 Sec. 19 Twp. 14 R. 13W

Well No. 2 Clyde

Coralena

Company

**FIRST REPORT**

Contractor

**SECTION PLAT**

C S L NW SW

990 Ft. from N. Line

\_\_\_\_\_ Ft. from S. Line

\_\_\_\_\_ Ft. from E. Line

660 Ft. from W. Line


HALL GURNEY POOL

Location X

Rig up \_\_\_\_\_

Drilling and Remarks:

**RECORD**

Cased \_\_\_\_\_ in., \_\_\_\_\_ ft.

Sand \_\_\_\_\_

Gas \_\_\_\_\_

Oil \_\_\_\_\_

Total Depth \_\_\_\_\_

**PRODUCTION**

1st 24 hrs. Nat. \_\_\_\_\_

1st 24 hrs. after shot \_\_\_\_\_

Gas \_\_\_\_\_ Cu. Ft.

Dry Hole \_\_\_\_\_

Abandoned \_\_\_\_\_

Date

APR 9 1941 19

S. J. LEWIS Scout

Map No. 72 Sec. 19 Twp. 14 R. 13W

Well No. 2 Clyde

Coralena Company

CORRECTION Contractor

C N L SW SW

\_\_\_\_\_ Ft. from N. Line

990 Ft. from S. Line

\_\_\_\_\_ Ft. from E. Line

574 Ft. from W. Line

HALL GURNEY POOL

**SECTION PLAT**


Location \_\_\_\_\_

Rig up \_\_\_\_\_

Drilling and Remarks:

Reported

C S L NW SW

**RECORD**

Cased \_\_\_\_\_ in., \_\_\_\_\_ ft.

Sand \_\_\_\_\_

Gas \_\_\_\_\_

Oil \_\_\_\_\_

Total Depth \_\_\_\_\_

**PRODUCTION**

1st 24 hrs. Nat. \_\_\_\_\_

1st 24 hrs. after shot \_\_\_\_\_

Gas \_\_\_\_\_ Cu. Ft.

Dry Hole \_\_\_\_\_

Abandoned \_\_\_\_\_

Date

APR 18 1941

19

S. J. LEWIS Scout

Map No. \_\_\_\_\_ Sec. 19 Twp. 14 R. 13W

Well No. 2 Clyde

Coralena \_\_\_\_\_ Company

COMPLETED \_\_\_\_\_ Contractor

C N L SW SW

\_\_\_\_\_ Ft. from N. Line

990 Ft. from S. Line

\_\_\_\_\_ Ft. from E. Line

574 Ft. from W. Line

**SECTION PLAT**

o			

**HALL GURNEY POOL**

Location \_\_\_\_\_

Rig up \_\_\_\_\_

Drilling and Remarks: \_\_\_\_\_

*Lans. 2907*

*5" @ 2927*

*6000 acid*

*Pump 48 P.Y.*

*383 Gr*

**RECORD**

Cased \_\_\_\_\_ in., \_\_\_\_\_ ft.

Sand \_\_\_\_\_

Gas \_\_\_\_\_

Oil \_\_\_\_\_

Total Depth 2979

**PRODUCTION**

1st 24 hrs. Nat. \_\_\_\_\_

1st 24 hrs. after shot \_\_\_\_\_

Gas \_\_\_\_\_ Cu. Ft.

Dry Hole \_\_\_\_\_

Abandoned \_\_\_\_\_

Date

JUN 4 1941 19

S. J. LEWIS Scout

S-513-B

O.W.W.O.

County Russell Elev. 1769  
 Sec. 19 Twp. 14 Rge. 13W  
 Company CRA  
 Farm Name Clyde No. 2

TOPS	DEPTH	LOG	DATUM	Loc. in Sec.
Anh. <u>Tarkio</u>	<u>2234</u>			<u>N<math>\frac{1}{2}</math> SW SW</u> <u>OWWO</u>
Tp.	<u>2658</u>			
H.				Geol. <u>O.W.W.O.</u>
Tr.				
Dg.				Contr. _____
B.L.				
L.	<u>3909</u>			Pool <u>Hall-Gurney</u>
K.C.				
B.K.C.				<div style="border: 1px dashed black; padding: 5px; text-align: center;"> <p><b>COMPLETE</b>  <b>FIRST REPORT</b>  MAY 21 1959</p> </div>
Ce.				
C.				
M.				
M.				
K.				
Mz.				
Mq.				
V.				
S.				
S.				
A.				
R.				
Pf.				
G.				
T.D.				

Date Comm. \_\_\_\_\_

OTD 2993 5" @ 2976 DD 3018 2000 A  
S/ 22 go 7 gw 2 hr. 2000 A PB 2450  
12/ 2429-30 12/ 2296-97 12/ 2250-51  
24/ 2364-70 wtr. frac  
Comp. 10 bopd 13 bw