

KANSAS

Form 51—5M—7-40—Palace

Barton

Section 11 Township 16 Range 14-W

Well No. #1 Templing

Company A. G. Kaiser et al

NORTH

Trapp Pool

							0

SOUTH

WEST


EAST

Sec. 11 - Twp. 16 R. 14-WWell No. #1 Templing FarmA. G. Kaiser et al Company

(Trapp)

 Ft. from N. Line660 Ft. from S. Line330 Ft. from E. Line Ft. from W. Line

Elev. 1926

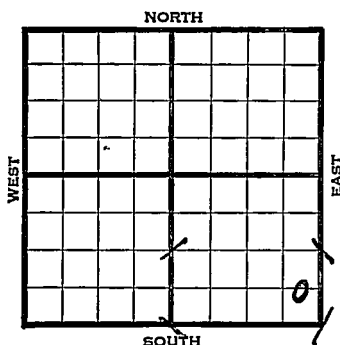

1940.

REPORT

10/2

8" - 58'

Anhy 897'

Drlg. 1700'

10/10

Topeka 2842'

Drlg. 2958'

10/17

Cong. 3338' Arb. 3341½-45' T.D.

5" - 3341½' RUST.

10/24

T.D. 3353' Depth. 2645 bbls.

10/30

Arb. 3341½'

5" - 3341½'

T.D. 3353'

1000 acid.

Dep thograph potential 2645 bbls.

COMPLETED

Map No. 73 Sec. 11 Twp. 16 R. 14WWell No. 1 TemplingA. G. Kaiser etal Company

Contractor


FIRST REPORT

C E L SE SE

 Ft. from N. Line660 Ft. from S. Line330 Ft. from E. Line Ft. from W. Line

TRAPP POOL

SECTION PLAT

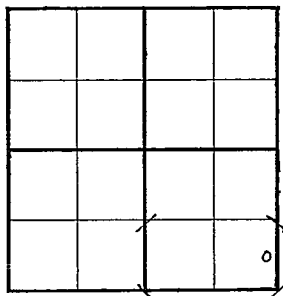Location Rig up

Drilling and Remarks:

8" - 58'

Anhy. 897

Dr1g. 1700

RECORD

Cased in., ft.Sand Gas Oil Total Depth

PRODUCTION

1st 24 hrs. Nat. 1st 24 hrs. after shot Gas Cu. Ft.Dry Hole Abandoned

Date

OCT 2 1940

19

S. J. LEWIS Scout

Map No. 73 Sec. 11 Twp. 16 R. 14WWell No. 1 TemplingA. G. Kaiser etal Company Contractor

COMPLETED

C E L S E S E

 Ft. from N. Line660 Ft. from S. Line330 Ft. from E. Line Ft. from W. Line

SECTION PLAT

			0

TRAPP POOL

Location Rig up

Drilling and Remarks:

Cu 8334 1/2
5" @ 334 1/2
1000 accoil
Depth to 82645

RECORD

Cased in., ft.Sand Gas Oil Total Depth 3353

PRODUCTION

1st 24 hrs. Nat. 1st 24 hrs. after shot Gas Cu. Ft.Dry Hole Abandoned

Date

OCT 30 1940 19 S. J. LEWIS Scout