

Barton

KANSAS

SECTION 11 TOWNSHIP 16S RANGE 14W

WELL NO. #5 Templing


COMPANY E.F. Wakefield

NORTH

N/2 N/2 SE

WEST

EAST

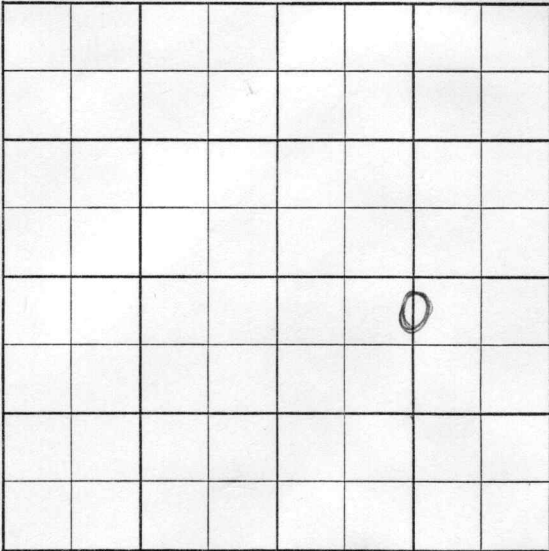

SOUTH

13

County Barton Elev. _____
 Sec. 11 Twp. 16 Rge. 14W
 Company E. F. Wakefield
 Farm Name Templing No. 5

TOPS	DEPTH	LOG	DATUM	Loc. in Sec. _____
Anh. _____				N/2 N/2 SE
Tp. _____				
H. _____				
Tr. _____				
Dg. _____				
B.L. _____				Geol. <u>G. Dent</u>
L. _____				Contr. _____
K.C. _____				Co. Tools #5
B.K.C. _____				
Ce. _____				Pool _____
C. _____				Trapp
M. _____				
M. _____				
K. _____				
Mz. _____				
Mq. _____				
V. _____				
S. _____				
S. _____				
A. _____				
R. _____				
Pf. _____				
G. _____				
T.D. _____				



Date Comm. _____

MIRT

Co.

Lse.

No.


Sec.

T.

R.

County Barton Elev. 1931 or 1937 RR
 Sec. 11 Twp. 16 Rge. 14W
 Company E. F. Wakefield
 Farm Name Templing No. 5

TOPS	DEPTH	LOG	DATUM	Loc. in Sec.
Anh.				N/2 N/2 SE
Tp.		2780		
H.		3082		
Tr.		3097		
Dg.		3113		
B.L.				
L.		3150		
K.C.				Geol. <u>G. Dent</u>
B.K.C.				Contr.
Ce.				Co. Tools #5
C.				
M.				
M.				
K.				Pool
Mz.				Trapp
Mq.				
V.				
S.				
S.				
A.		3370		
R.				
Pf.				
G.				
T.D.	3420			

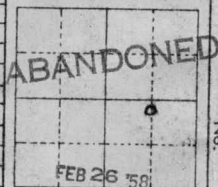

Date Comm. 2-11-58
 MIRT 10' 58 8" 650 42020

26-58 DST 3190-90 30" 10'M
BHP 580/30 DST 3370-90 30"
6'M BHP 114/30" DST 3391-98
30" 7'M BHP 140/30"

D 6 A