

KANSAS

Russell

Form 51-5M-7-39-Palace


C.W.W.O.

Section 19 Township 14 Range 13-W

Well No. #1 ~~Phinney~~ Clyde

Company Coralena C.R.A.

NORTH Hall Pool 13

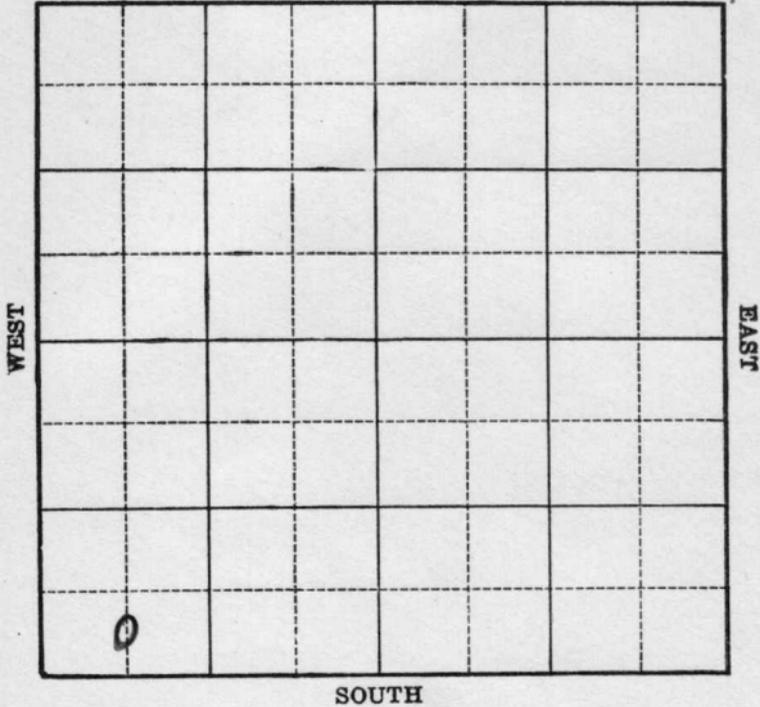

Sec. 19 Twp. 14 R. 13-W

Well No. #1 ~~Phinney~~ Clyde Farm

Coralena Company

(Hal 1)


_____ Ft. from N. Line

330 Ft. from S. Line

_____ Ft. from E. Line

660 Ft. from W. Line

Elev. 1737

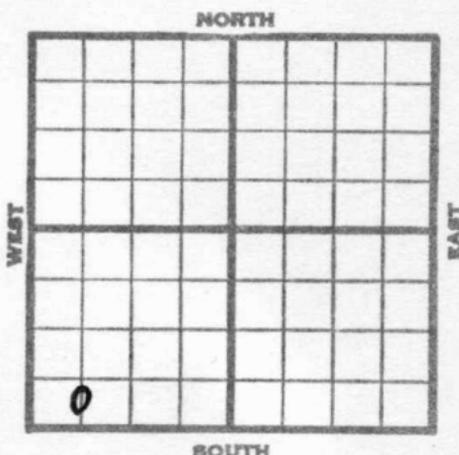

1940	REPORT
2/14	Derrick.
2/23	10" - 251' Anhy 685' Drlg. 2025'
2/29	Lans. 2870' Drlg. 2955'
3/8	T.D. 3090' 5½" - 3055' RUST. Pay 2964-69' Will perforate.
3/14	P.B. to 2970½' 24 shots 2906 to 2910' 8000 acid.
3/21	Testing.
3/27	Lans. 2870'
	5" - 3055'
	T.D. 3090'
	24 shots 2906-10'
	8000 acid.
	Pump 2242 bbls., potential.
	COMPLETED

Map No. 72 Sec. 19 Twp. 14 R. 13W

Well No. 1 Phinney
Coralena Company _____

Contractor _____

FIRST REPORT

C S L SW SW


_____ Ft. from N. Line

330 Ft. from S. Line

_____ Ft. from E. Line

660 Ft. from W. Line

SECTION PLAT

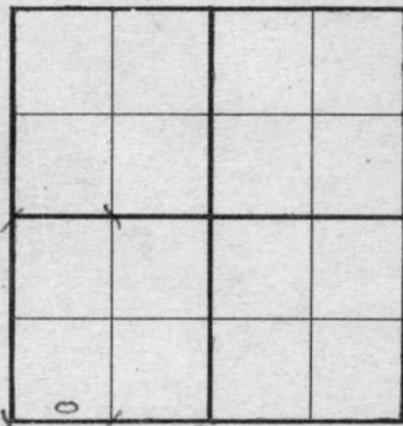

HALL POOL

Location _____

Rig up _____

Drilling and Remarks:

Derrick

RECORD

Cased _____ in., _____ ft.

Sand _____

Gas _____

Oil _____

Total Depth _____

PRODUCTION

1st 24 hrs. Nat. _____

1st 24 hrs. after shot _____

Gas _____ Cu. Ft.

Dry Hole _____

Abandoned _____

Date

FEB 14 1940 19

S. J. LEWIS

Scout

Map No. 72 Sec. 19 Twp. 14 R. 13W

Well No. 1 Clyde

Coralena Company

CORRECTION Contractor

SECTION PLAT

C S L SW SW


_____ Ft. from N. Line

330 Ft. from S. Line

_____ Ft. from E. Line

660 Ft. from W. Line

HALL POOL

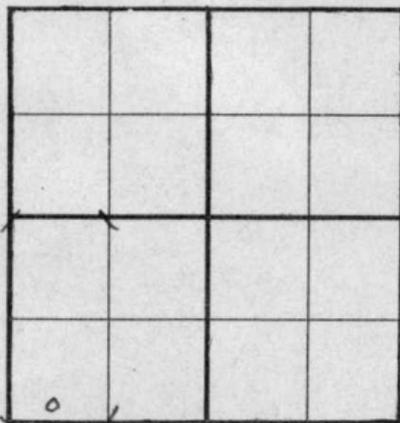

Location _____

Rig up _____

Drilling and Remarks:

Reported as

#1 Phinney

RECORD

Cased _____ in., _____ ft.

Sand _____

Gas _____

Oil _____

Total Depth _____

PRODUCTION

1st 24 hrs. Nat. _____

1st 24 hrs. after shot _____

Gas _____ Cu. Ft.

Dry Hole _____

Abandoned _____

Date

FEB 28 1940

19

S. J. LEWIS

Scout

Map No. 72 Sec. 19 Twp. 14 R. 13W

Well No. 1 Clyde

Coralena Company

Contractor

COMPLETED

C S L SW SW

 Ft. from N. Line

330 Ft. from S. Line

 Ft. from E. Line

660 Ft. from W. Line

HALL POOL

SECTION PLAT

Location

Rig up

Drilling and Remarks:

Lians. 2870
5" C3055.
24 Shots 2906-10
5000 Acid
Pump. 2242 Pst.

RECORD

Cased in., ft.

Sand

Gas

Oil

Total Depth 3090

PRODUCTION

1st 24 hrs. Nat.

1st 24 hrs. after shot

Gas Cu. Ft.

Dry Hole

Abandoned

Date

MAR 27 1940 19

S. J. LEWIS Scout

~~THE~~ ~~PAID~~ ~~O.W.W.O.~~
~~CO.~~ ~~PAID~~ ~~12~~

S-513-B

County Russell Elev. 1737DF
 Sec. 19 Twp. 14 Rge. 13W
 Company C. R. A.
 Farm Name Clyde No. 1

TOPS	DEPTH	LOG	DATUM
Anh.			
Tp.			
H.			
Tr.			
Dg.			
B.L.			
L. K	2870		
K.C.			
B.K.C.			
Ce.			
C.			
M.			
M.			
K.			
Mz.			
Mq.			
V.			
S.			
S.			
A.			
R.			
Pf.			
G.			
T.D.	3097		

Loc. in Sec. S/2 SW SW
(O.W.W.O.)
 Geol. O.W.W.O.
 Contr. _____
 Pool _____
Hall-Gurney

APR 9 1948
FIRST REPORT COMPLETE

Date Comm. OLD INFO: TOPS: OTD 3089, PB 2970
5" @ 3055, LK well, Comp 2/29/40
NEW INFO: CO DD 3097 TD, GRN log, Swb 16 BO
+ 12 BW/4 hrs, 60/2956-71 Swb 31.5 BO * 43
BW/12 hrs (from old perfs 2906-14, Swb 11.6
BO + 15 BW/4 hrs) 500A in perfs 2956-71,
2906-14, 1500A in @ 2956-71, POP P 31.7 BO
+ 64 BWPD LK perfs 2906-71, TD 3097 COMPLETE

Co. _____
 Lse. _____
 No. _____
 Sec. _____
 T. _____
 R. _____