


Section 12 Township 16 Range 14W

Well No. 4 Hoffman

Company Hinkle Oil

Trapp
NORTH

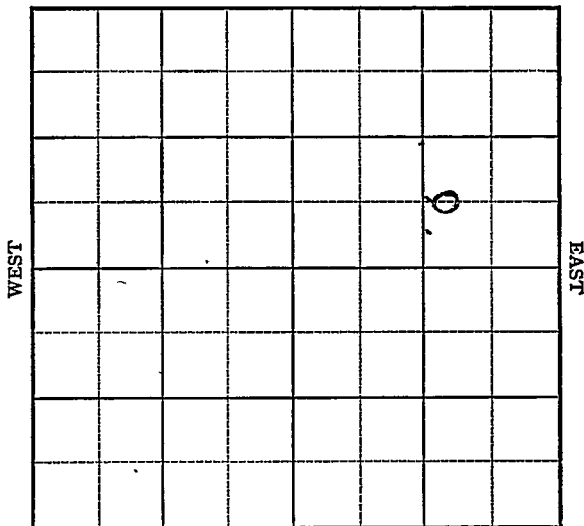

SOUTH

O.W.W.O.

Barton

KANSAS ✓

Sec. 12 Twp. 16 R. 14W

Well No. #4 Hoffman Farm

Hinkle Oil Company


Trapp Pool (Hinkle Oil, Cont.) ^{NORTH}

_____ Ft. from N. Line

660' _____ Ft. from S. Line

990' _____ Ft. from E. Line

_____ Ft. from W. Line

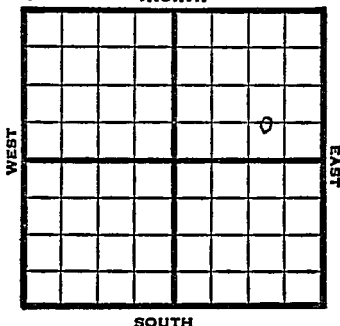

C W L S E N E

1949 ELEV 1903' REPORT

8/3	8" @ 164' Anhy 860' Drlg. 2406'
8/10	Lansing 3091' Arb. 3317-21' TD 3321' 5" @ 3318'
8/17	TD 3344 500 acid Swb 10 oil PH 3 hrs.
8/24	"
8/31	"
9/7	"
9/14	"
9/21	"
9/28	TD 3344' Lansing 3091' Arb. 3317' 5 @ 3318' Perf Lans 1000 acid Pump 50 B Oil / 4% W Pot 40 ⁹ Gr. omp

COMPLETED

OVER

O.W.W.O.

1951
2/28

Oil well TD 3350'
Lans 3089' Arb. 3315'
OTD 3344'
5" @3318
DD 3350' 500 A
Comp. 100 bopd 10% water

FIRST REPORT
✓
COMPLETED

Kansas

Trapp Pool

Map No. _____ Sec. 12 Twp. 16 R. 14W

Well No. 4 Hoffman

Hinkle Oil _____ Company

Hinkle Oil _____ Contractor

C W L SE NE

FIRST REPORT
SECTION PLAT

_____ Ft. from N. Line

660 _____ Ft. from S. Line

990 _____ Ft. from E. Line

_____ Ft. from W. Line

			6

Barton County

Location _____

Rig up _____

Drilling and Remarks: _____

8" @ 164.

anh \bar{y} 860

2406

RECORD

Cased _____ in., _____ ft.

Sand _____

Gas _____

Oil _____

Total Depth _____

PRODUCTION

1st 24 hrs. Nat. _____

1st 24 hrs. after shot _____

Gas _____ Cu. Ft.

Dry Hole _____

Abandoned _____

Date

AUG 3 1949 19

S. J. LEWIS Scout

Map No. _____ Sec. 12 Twp. 16 R. 14W

Well No. 4 Hoffman

Hinkle Oil

Company

COMPLETE

Contractor

C W L S E N E

E 11903
SECTION PLAT

_____ Ft. from N. Line

660 Ft. from S. Line

990 Ft. from E. Line

_____ Ft. from W. Line

			o

Barton County

RECORD

Location _____

Cased _____ in., _____ ft.

Rig up _____

Sand _____

Drilling and Remarks:

Gas _____

Home 3091

Oil _____

CR 43317.

Total Depth 3244

5" @ 3318.

Ref Home.

1000 acid

Pin 5000 ft +

4400 W Pat.

PRODUCTION

1st 24 hrs. Nat. _____

1st 24 hrs. after shot _____

Gas _____ Cu: Ft.

Dry Hole _____

Abandoned _____

Date

40 Feb.

SEP 28 1949

19

S. J. LEWIS

Scout

County Barton State Kansas

Sec. 12 (Blk. Twp.) 16 (Sur. Rge.) 14W Map No.

Operator Hinkle Oil

Well No. 4 Farm Hoffman "B"

Elev. 1903 Location C W L SE NE

FIRST REPORT
✓
COMPLETE

660 Ft. From S Line NE

990 Ft. From E Line Quarter

1st. Report FEB 28 1951

Completion FEB 28 1951

Remarks OWWO

Spudding Date _____

Drlg. Data Oil well TD 3350

Lans. 3089 Arb. 3315 OTD 3344 5" @ 3318

DD 3350 500 A. Comp. 100 bopd 10% water

J. E. TYRA