


Section 19 Township 14 Range 13W

Well No. #7 Clyde Phinney

Company C R A

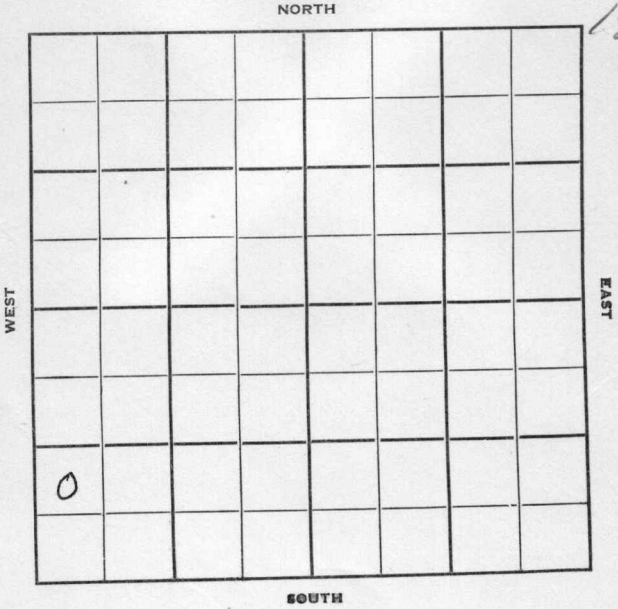

Sec. 19 Twp. 14 R. 13W

Well No. #7 Clyde Phinney Farm

C R A Company

C R A  
Hall-Gurney Pool Contractor


\_\_\_\_\_ Ft. from N. Line

990 Ft. from S. Line

\_\_\_\_\_ Ft. from E. Line

330 Ft. from W. Line

NW SW SW

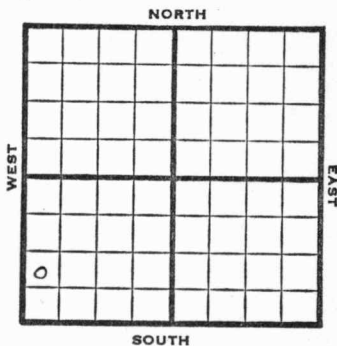

1951 Elev. 1757' REPORT

10/24 Spud 10-21-51  
13" @ 210'  
WOC

11/7 Spud 10-21-51  
Oil Well TD 2304  
13" @ 210  
Indian cave sd. 2003  
1st Tarkio 2272  
2nd Tarkio 2288-90  
5" @ 2289 TD 2304  
23 GO 1 hr. Hydro  
S/ 3 BOPH Comp. 50 BOPD

**COMPLETED**



