


Section 19 Township 14 Range 13 W

Well No. # 11 Clyde Phinney

Company CRA

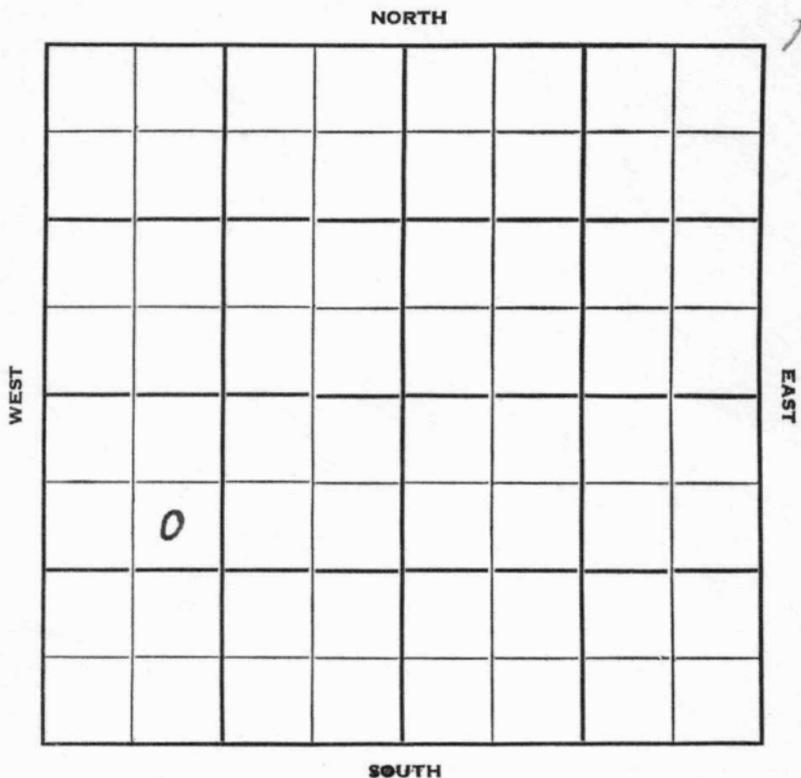

Sec. 19 Twp. 14 R. 13 W

Well No. # 11 Clyde Phinney Farm

C R A Company

Sunflower Drlg. Contractor


Hall-Burney Pool

990 Ft. from N. Line

Ft. from S. Line

Ft. from E. Line

990 Ft. from W. Line

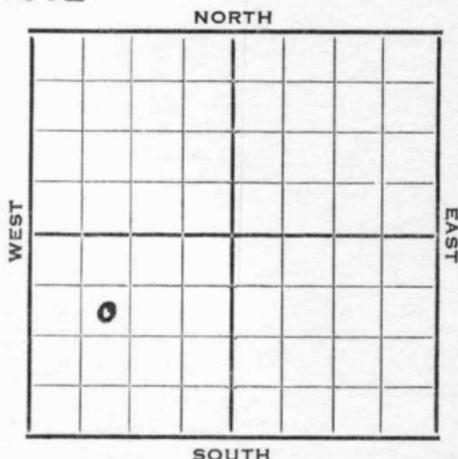

SE NW SW

1952 Elev. 1777' REPORT

6/11 Spud 6-6-52
8" @ 195'
Drlg. 1545'

6/18 1st Tarkio 2297' 2nd Tarkio 2307-
2310' RTD. 5" @ 2308'

6/25 DD 2325' TD S-frac. S/load

7/2 Spud 6-6-52
Oil Well TD 2325 8" @ 195
1st Tar 2292 2nd Tar 2307
TD 2310 5" @ 2308 DD 2325
Stratofrac S/ load P/ 39½ bo
Comp. 39½ bopd 9¼ bw

COMPLETED

