


KANSAS

FORM 51 25M 3-49 PETROL

Section 12 Township 16 Range 14-W

Well No. #7 Hoffman

Company Hinkle et al

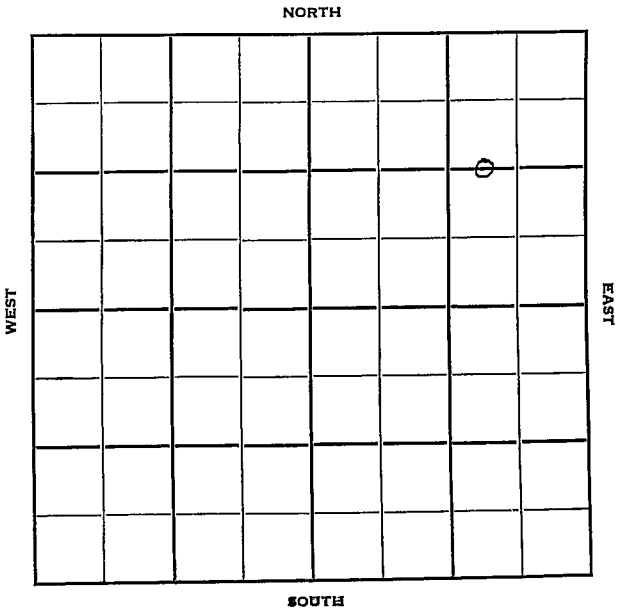

Barton

KANSAS

Sec. 12 Twp. 16 R. 14W ✓

Well No. #7 Hoffman Farm

Hinkle et al Company

Contractor

Trapp Pool


1320' Ft. from N. Line

Ft. from S. Line

990' Ft. from E. Line

Ft. from W. Line

C W L E $\frac{1}{2}$ NE

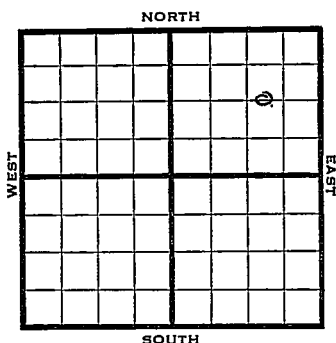

1950	Elev 1909 REPORT
7/5	Spud 7-2-50 8" @ 204' WOC
9/6	8" @ 204 Anhy 765 Lans 3103 Arb 3324-26 5" @ 3324 $\frac{1}{2}$ TD 3326 S/4 BOPH 500' off bottom Comp 75 bopd Completed COMPLETED

Map No. _____ Sec. 12 Twp. 16 R. 14W

Well No. 7 Hoffman

Hinkle et al.

Company

Contractor

C W L E $\frac{1}{2}$ NE

SECTION PLAT

1320 Ft. from N. Line

Ft. from S. Line

990 Ft. from E. Line

Ft. from W. Line



Barton County

Location _____

Rig up _____

Drilling and Remarks:

Spud 7-2-50

8" @ 204

WOC

RECORD

Cased _____ in., _____ ft.

Sand _____

Gas _____

Oil _____

Total Depth _____

PRODUCTION

1st 24 hrs. Nat. _____

1st 24 hrs. after shot _____

Gas _____ Cu. Ft.

Dry Hole _____

Abandoned _____

Date

JUL 5 1950 19

J. E. TYRA Scout

check spot

Check spot and feet measurements

Advise

Sam

Scout Cards <i>FW</i>
Land Small Map <i>U</i>
Land Wall Map
Tracings
France Map
Pierce Map
Misc.

SEP 15 1950

Orig. Data