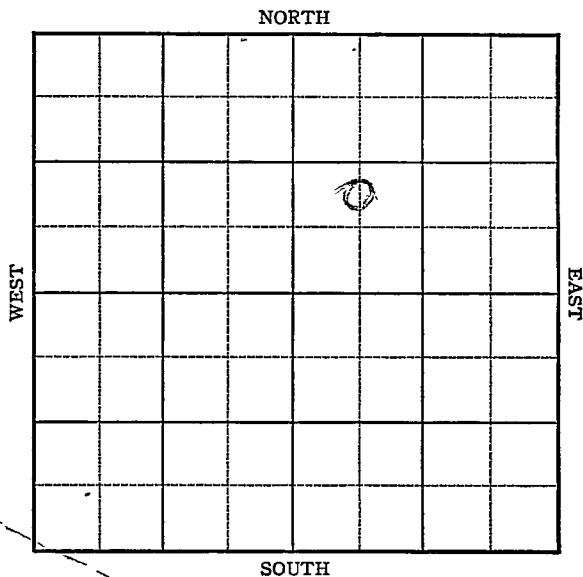


KANSAS

Barton county

Section 12 Township 16 Range 14WWell No. #2, Hoffman "B"Company Hinkle & Franco Central

KANSAS

Barton County ✓

Sec. 12 Twp. 16 R. 14WWell No. #2 Hoffman "B" FarmHinkle & Franco Central Company

Trapp

Ft. from N. Line


990

Ft. from S. Line

Ft. from E. Line

660

Ft. from W. Line

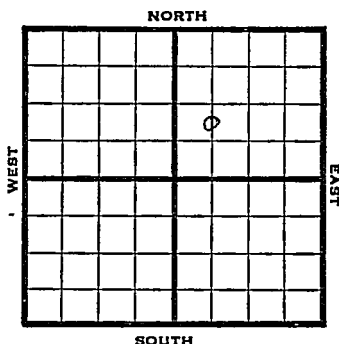

CNL SW NE

1946	Elev. 1899	REPORT
4/10	10" @ 168 Drlg. 1535'	
4/16	" "	
4/23	Lans 3106 Cong 3219 Arb 3326-40 TD 5 @ 334 RUST	
5/1	500 acid swb 25 oil PH 8 hrs	
5/7	" " "	
5/14	Pump 40 oil in 8 hrs.	
5/22	Arb. 3326 5" @ 3334 TD 3346' Depth Pot. 849 Grav. 40.9	

COMPLETED


Kansas Pool Name TrappKANSAS
Map No. 73 Sec. 12 Twp. 16 R. 14WWell No. 2 Hoffman "B"Hinkle & Franco Central Company

FIRST REPORT

Contractor

C N L SW NE

SECTION PLAT

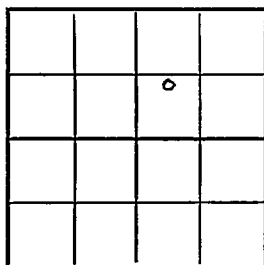 Ft. from N. Line990 Ft. from S. Line Ft. from E. Line660 Ft. from W. LineBarton CountyLocation Rig up

Drilling and Remarks:

10" @ 168

Drlg 1535

RECORD

Cased in., ft.Sand Gas Oil Total Depth

PRODUCTION

1st 24 hrs. Nat. 1st 24 hrs. after shot Gas Cu. Ft.Dry Hole Abandoned

Date

APR 10 1946

19

S. J. LEWIS Scout

KANSAS Kansas Pool Name Trapp PoolMap No. 23 Sec. 12 Twp 16 R. 14WWell No. 2 Hoffman "B"Hinkle & Franco Central Company**COMPLETED**

Contractor

C N L SW NE

E 11899

SECTION PLAT

		0	

 Ft. from N. Line990 Ft. from S. Line Ft. from E. Line660 Ft. from W. LineBarton CountyLocation Rig up

Drilling and Remarks:

Cr 23265' 03334Dep 140254940-9-44**RECORD**Cased in., ft.Sand Gas Oil Total Depth 2346**PRODUCTION**1st 24 hrs. Nat. 1st 24 hrs. after shot Gas Cu. Ft.Dry Hole Abandoned

Date

MAY 22 194619S. J. LEWISScout