KANSAS


Saline

FORM 51 5M PETROL

Section 29 Township 16 Range 1-W

Well No. #1 Kraber "B"

Company Bay Petr.

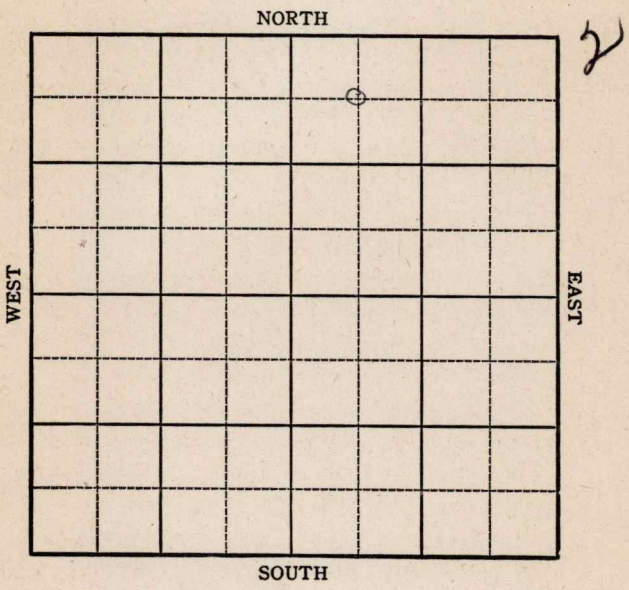

FORM 252-A
5M 9-43 GASS

KANSAS

Saline

Sec. 29 Twp. 16 R. 1 W

Well No. #1 Kraber "B" Farm

Bay Petr. Company


660 Ft. from N. Line

Ft. from S. Line

Ft. from E. Line

660 Ft. from W. Line

Elev. 1290

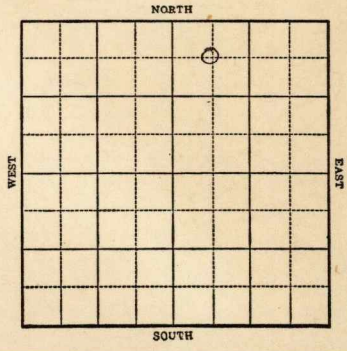

1943	REPORT
12-8	Location
12-15	"
12/22	"
12/29	Rotary
1944	
1-5	8" @ 145 WOC
1-12	Drlg 2330'
1/19	Lans 2000 Miss 2620 TD 2621½ SO 5" @ 2620½ RUST
1/26	5" @ 2620½ Miss 2620 500 acid TD 2624 Pump 120 Pot. Gravity 36.8

COMPLETED

Form 26 200 Bks 5-42 Petrol Saline

KANSAS

Map No. 12 Sec. 29 Twp. 16 R. 1W


Well No. 1 Kraber "B"

Bay Pet. Company

FIRST REPORT Contractor

C NW NE

SECTION PLAT

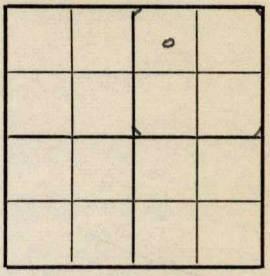

660 Ft. from N. Line

_____ Ft. from S. Line

_____ Ft. from E. Line

660 Ft. from W. Line

Hunter Pool

Location X

Rig up

Drilling and Remarks:

RECORD

Cased _____ in., _____ ft.

Sand

Gas

Oil

Total Depth

PRODUCTION

1st 24 hrs. Nat.

1st 24 hrs. after shot

Gas _____ Cu. Ft.

Dry Hole

Abandoned

Date

DEC 8 1943 19 S. J. LEWIS Scout

Form 26 200 Bks 5-42 Petrol Saline

KANSAS

Map No. 27 Sec. 29 Twp. 16 R. 1W

Well No. 1 Kraber "B"

Bay Petl Company

COMPLETED

Contractor

C NW NE


660 Ft. from N. Line

Ft. from S. Line

Ft. from E. Line

660 Ft. from W. Line

SECTION PLAT

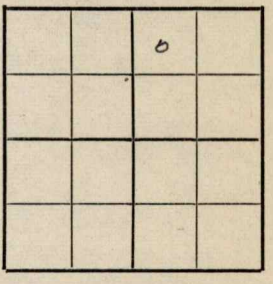

Hunter Pool

Location

Rig up

Drilling and Remarks:

Miss 2620
5" @ 2620½
500 acid
Pump 120 BO

36 E 4N

RECORD

Cased in., ft.

Sand

Gas

Oil

Total Depth 2624

PRODUCTION

1st 24 hrs. Nat.

1st 24 hrs. after shot

Gas Cu. Ft.

Dry Hole

Abandoned

Date

JAN 26 1944 19

S. J. LEWIS Scout