

KANSAS

Russell


FORM 51 5M 4-41 PETROL

Section 19 Township 14 Range 13-W

Well No. #3 Clyde

Company Coralena

NORTH Trapp Pool 12

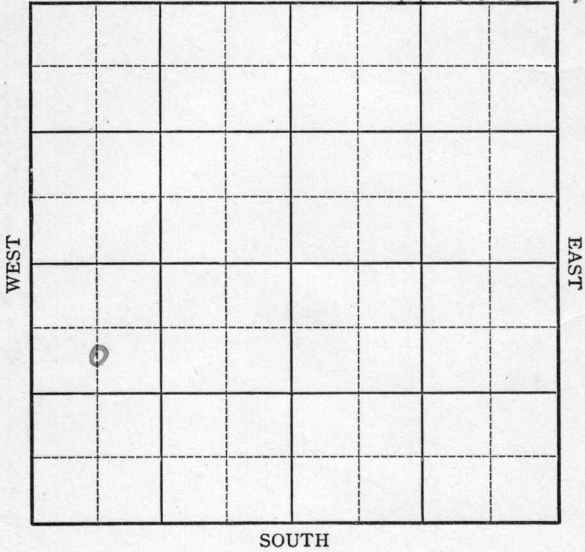

Sec. 19 Twp. 14 R. 13-W

Well No. #3 Clyde Farm

Coralena Company


(Trapp)

990 Ft. from N. Line

\_\_\_\_\_ Ft. from S. Line

\_\_\_\_\_ Ft. from E. Line

660 Ft. from W. Line

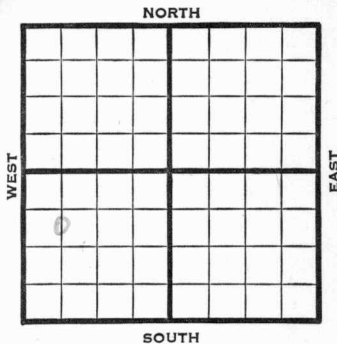

Elev. 1761

1942	REPORT
6/3	Derrick.
6/10	10" - 190' WOC.
6/17	Drlg. 2280'
6/24	Lans. 2896-82' T.D. 7" - <sup>2932'</sup> <del>2982'</del> RUST.
7/1	" " "
7/8	2000 acid. Pump 6 to 7 oil per hour on time.
7/15	" " "
7/22	7" @ 2932 (Correction)
	Lans. 2896'
	T.D. 2952 (Corrected)
	2000 acid
	Pump 72 Pot.
	Gravity 39.
	<b>COMPLETED</b>

Rus sell

Map No. 72 Sec. 19 Twp. 14 R. 13W

Well No. 3 Clyde

Coralena Company

FIRST REPORT Contractor

C SL NW SW

990 Ft. from N. Line

\_\_\_\_\_ Ft. from S. Line

\_\_\_\_\_ Ft. from E. Line

660 Ft. from W. Line

SECTION PLAT


TRAPP POOL

Location \_\_\_\_\_

Rig up \_\_\_\_\_

Drilling and Remarks:

Derrick

RECORD

Cased \_\_\_\_\_ in., \_\_\_\_\_ ft.

Sand \_\_\_\_\_

Gas \_\_\_\_\_

Oil \_\_\_\_\_

Total Depth \_\_\_\_\_

PRODUCTION

1st 24 hrs. Nat. \_\_\_\_\_

1st 24 hrs. after shot \_\_\_\_\_

Gas \_\_\_\_\_ Cu. Ft.

Dry Hole \_\_\_\_\_

Abandoned \_\_\_\_\_

Date

JUN 3 1947

19

S. J. LEWIS Scout

Map No. 72 Sec. 19 Twp. 14 R. 13W KANSAS

Well No. 3 Clyde  
Coralena Company

COMPLETED Contractor

**C S L NW SW**  
990 Ft. from N. Line  
 \_\_\_\_\_ Ft. from S. Line  
 \_\_\_\_\_ Ft. from E. Line  
660 Ft. from W. Line

**SECTION PLAT**


**TRAPP POOL**

Location \_\_\_\_\_

Rig up \_\_\_\_\_

Drilling and Remarks:

*Lane 2896*  
*7" C 2932 Connected*  
*2000 Acid*  
*Purge 72 Pst*  
  
*39° 44'*

**RECORD**

Cased \_\_\_\_\_ in., \_\_\_\_\_ ft.  
 Sand \_\_\_\_\_  
 Gas \_\_\_\_\_  
 Oil \_\_\_\_\_  
 Total Depth 2952 *Connected*

**PRODUCTION**

1st 24 hrs. Nat. \_\_\_\_\_  
 1st 24 hrs. after shot \_\_\_\_\_  
 Gas \_\_\_\_\_ Cu. Ft.  
 Dry Hole \_\_\_\_\_  
 Abandoned \_\_\_\_\_

Date

JUL 22 1942 19

S. J. LEWIS Scout

O.W.W.O.

~~Section 19-14S-13W~~  
~~Section 19-14S-13W~~

S-513-B

County Russell Elev. 1761 DF  
 Sec. 19 Twp. 14S Rge. 13W  
 Company C. R. A.  
 Farm Name Clyde No. 3

TOPS	DEPTH	LOG	DATUM
Anh.			
Tp.			
H.			
Tr.			
Dg.			
B.L.			
L.- <b>KC</b>	<b>2896</b>		
K.C.			
B.K.C.			
Ce.			
C.			
M.			
M.			
K.			
Mz.			
Mq.			
V.			
S.			
S.			
A.			
R.			
Pf.			
G.			
T.D.			

Loc. in Sec. S/2 NW SW  
O.W.W.O.  
**O.W.W.O.**  
 Geol. \_\_\_\_\_  
 Contr. \_\_\_\_\_  
 Pool Hall-Gurney



Date Comm. OTD 2987 (corr.); 7" 2930; LK well comp. 6-20-42; New info - CO 2987, OTD, no tests; DD 3005; 2300 A; 1500 A @ 2975-79 (open hole); swb 12.76 bo / 18.67 bw 1 hr. swb 70 bw / 172 bw 20 hrs. (from 2930 to 3006 32/2904-12; 80/2926-46; set pkr. @ 2879; 1500 A; set plug @ 2949; plug came up to 2915; 1500 A; CO plug @ 2915; re-set baker plug at 2952; swb 18.64 bo / 184 bw 10 hr.; Baker plug @ 2450; 4/2399-2400; re-cem. csg. w/150; CO DD 3014 TD; POP; pmp 39 bo /

111.74 bw 24 hrs.; pmp 25 bo / 40 bwpd 30  
days

Complete LK Prod.