

KANSAS


FORM 51 5M 1-42 PETROL

Russell

Section 11 Township 15 Range 14-W

Well No. #1 Flegler "B"

Company Pryor & Lockhart etal

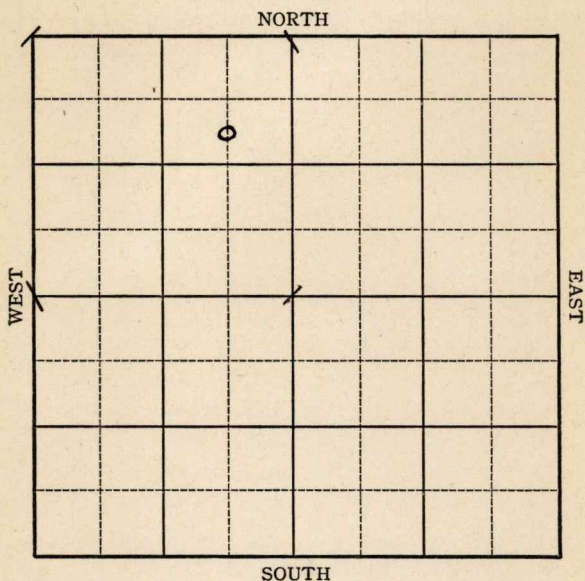


Sec. 11 Twp. 15 R. 14-WWell No. #1 Flegler "B" FarmPryor & Lockhart etal Company

Trapp

990 Ft. from N. Line Ft. from S. Line660 Ft. from E. Line Ft. from W. Line

Elev. 1760

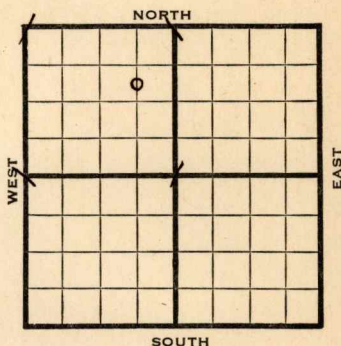

1943

REPORT

8/4 Spud 7-30-42
15" @ 55'
Drlg. 460'

8/11 13" @ 414'
10" @ 770'
Drlg. 750'

8/18 Tarkio 2520
SO & G
Drlg. 2540'

8/25 Anny 765
8" @ 2386
Topeka 2654
Drlg. 2800

9/1 Dodge 2902 SO
Lans 2971
T.D. 2990-1250 in 6 hrs.

9/8 7" @ 3108
SO 3168-70
Arb 3214 Sat
Run 5"

9/15 5" @ 3214
T.D. 3219'

9/22 Arb 3214
5" @ 3214
Pump 825 Pot.
Gravity 40.7
T.D. 3228'

COMPLETED


KANSAS RussellMap No. 73 Sec. 11 Twp. 15 R. 14WWell No. 1 Flegler "B"Pryor & Lockhart et al. Company

FIRST REPORT

Contractor

C SL NE NW

SECTION PLAT

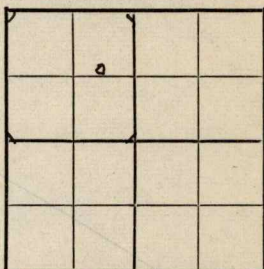990 Ft. from N. Line

Ft. from S. Line

660 Ft. from E. Line

Ft. from W. Line

TRAP P POOL

Location _____

Rig up _____

Drilling and Remarks:

Spud 7-30-42

15"-55'

Drlg. 460'

RECORD

Cased _____ in., _____ ft.

Sand _____

Gas _____

Oil _____

Total Depth _____

PRODUCTION

1st 24 hrs. Nat. _____

1st 24 hrs. after shot _____

Gas _____ Cu. Ft.

Dry Hole _____

Abandoned _____

Date

AUG 4 1943 19S. J. LEWIS Scout

KANSAS

Map No. 73 Sec. 11 Twp. 15 R. 14WWell No. 1 Flegler "B"Pryor & Lockhart et al. Company

COMPLETED

Contractor

C S L NE NW


990 Ft. from N. Line

Ft. from S. Line

660 Ft. from E. Line

Ft. from W. Line

SECTION PLAT

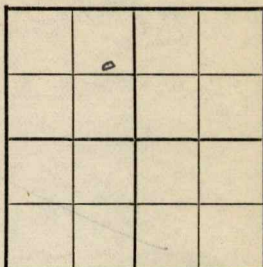

Trapp Pool

Location

Rig up

Drilling and Remarks:

*Cor 3214**5" 3214**Pump 525 BT**40 2 Gr*

RECORD

Cased _____ in., _____ ft.

Sand _____

Gas _____

Oil _____

Total Depth *8225*

PRODUCTION

1st 24 hrs. Nat. _____

1st 24 hrs. after shot _____

Gas _____ Cu. Ft.

Dry Hole _____

Abandoned _____

Date

SEP 22 1943 19

S. J. LEWIS Scout