


Section 19 Township 14 Range 13W

Well No. #8 Clyde Phinney

Company C R A

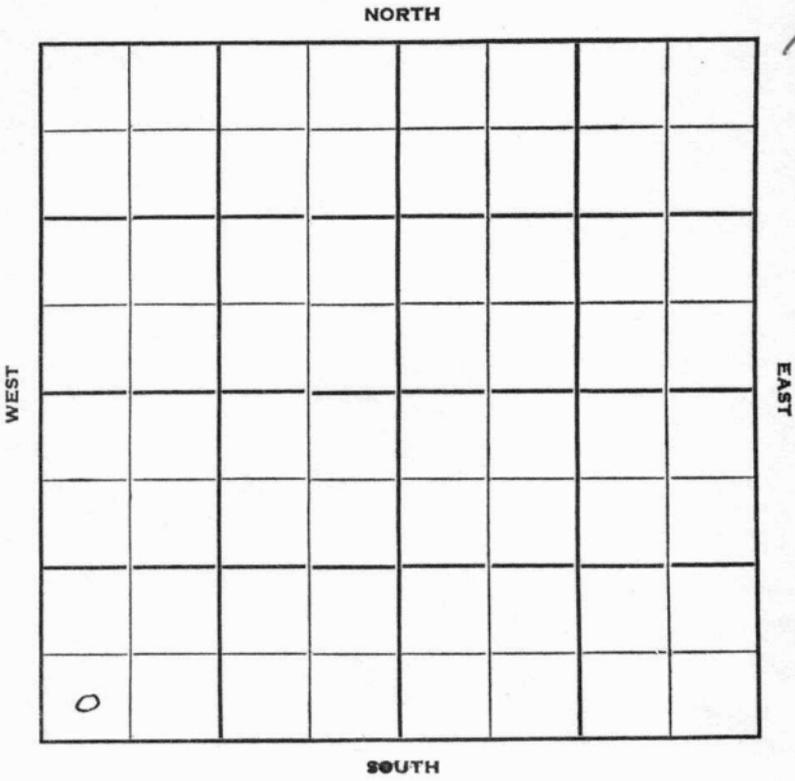

Russell

KANSAS

Sec. 19 Twp. 14 R. 13 W

Well No. # 8 Clyde Phinney Farm

C R A Company

C R A Contractor

Hall-Gurney Pool


Ft. from N. Line

330 Ft. from S. Line

Ft. from E. Line

330 Ft. from W. Line

SW SW SW

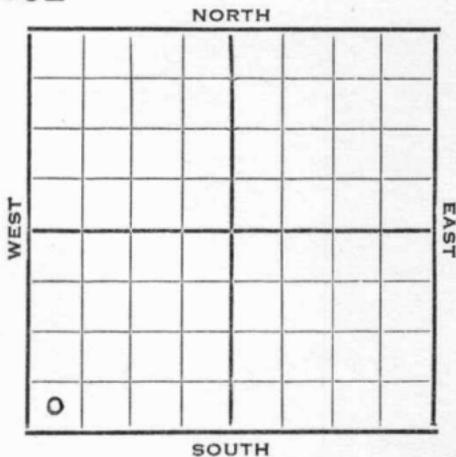

1951

Ely 1735'

REPORT

12/5

Spud 12-2-51
10" @ 195
Drlg. 360'

1952
1/9

Spud 12-2-51 Oil well TD 2285'
10" @ 195 Indian Cave 1995'
1st Tarkio 2250' 2nd Tarkio 2264-65
7" @ 2265' TD 2285' B/3/4 BOPH
Hydro. S/7 BOPH 19 hr.
Comp. 50 BOPD

COMPLETED

