

KANSAS


Russell

Form 51-5M-7-39-Palace

Section 19 Township 14 Range 13-W

Well No. #2 Ehrlich

Company Coralena

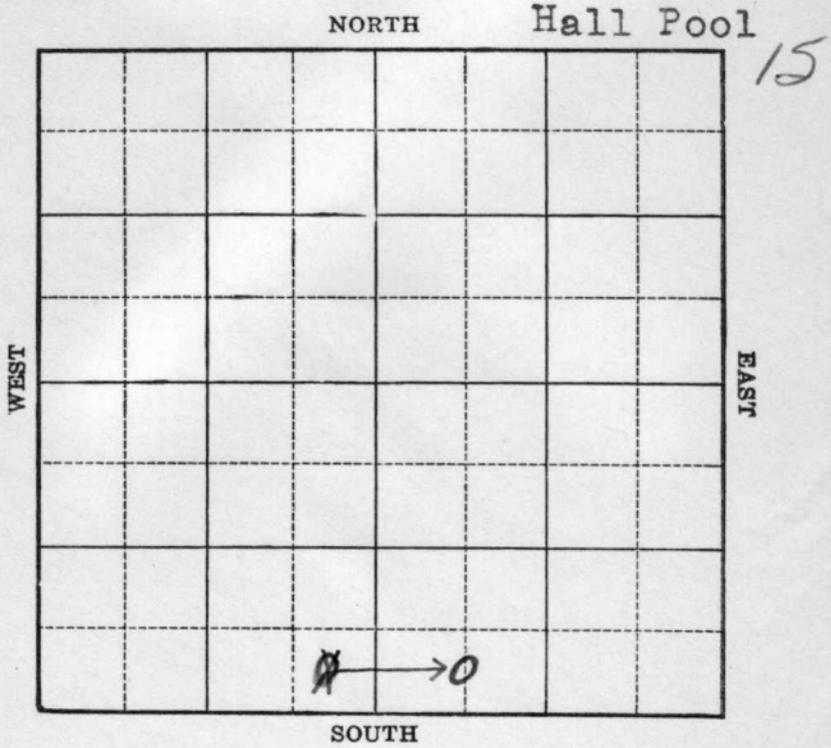

Sec. 19 Twp. 14 R. 13-W

Well No. #2 Ehrlich Farm

Coralena Company


(Hal 1)

Ft. from N. Line

330 Ft. from S. Line

330 Ft. from E. Line

660 Ft. from W. Line

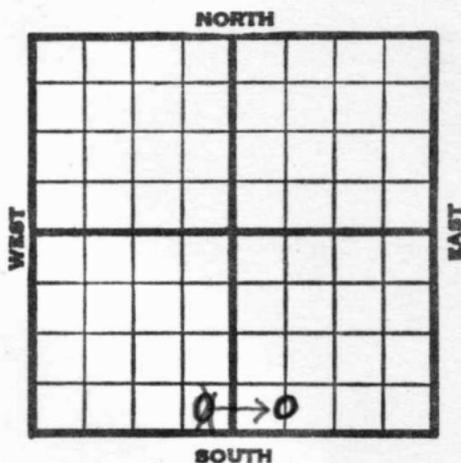

1940	REPORT
3/13	Location
3/21	Derrick.
3/28	11" - 238' Topeka 2656'
	S.O. 2775-80' Drlg. 2870'
4/4	Lans. 2913' T.D. 2945'
	5" - 2945' RUST.
4/12	" " "
4/18	" " "
4/24	Lans. 2913'
	5" - 2945'
	T.D. 2955'
	4000 acid.
	Pump 121 bbls.
	COMPLETED

Map No. 72 Sec. 19 Twp. 14 R. 13W

Well No. 2 Ehrlich

Coralena Company

Contractor

FIRST REPORT

SE SW

_____ Ft. from N. Line

330 Ft. from S. Line

330 Ft. from E. Line

_____ Ft. from W. Line

SECTION PLAT

HALL POOL

Location X

Rig up _____

Drilling and Remarks:

RECORD

Cased _____ in., _____ ft.

Sand _____

Gas _____

Oil _____

Total Depth _____

PRODUCTION

1st 24 hrs. Nat. _____

1st 24 hrs. after shot _____

Gas _____ Cu. Ft.

Dry Hole _____

Abandoned _____

Date

MAR 13 1940 19

S. J. LEWIS Scout

Map No. 72 Sec. 19 Twp. 14 R. 13W

Well No. 2 Ehrlich

Coralena

Company

CORRECTION

Contractor

SECTION PLAT

C S L SW SE

_____ Ft. from N. Line

330 Ft. from S. Line

_____ Ft. from E. Line

660 Ft. from W. Line

HALL POOL

Location _____

Rig up _____

Drilling and Remarks:

Reported SE SW

RECORD

Cased _____ in., _____ ft.

Sand _____

Gas _____

Oil _____

Total Depth _____

PRODUCTION

1st 24 hrs. Nat. _____

1st 24 hrs. after shot _____

Gas _____ Cu. Ft.

Dry Hole _____

Abandoned _____

Date

APR 3 1940

19

S. J. LEWIS

Scout

Map No. 72 Sec. 19 Twp. 14 R. 13W

Well No. 2 Ehrlich

Coralena

Company

Contractor

COMPLETED

SECTION PLAT

C S L SW SE

_____ Ft. from N. Line

330 Ft. from S. Line

_____ Ft. from E. Line

660 Ft. from W. Line

HALL POOL

Location _____

Rig up _____

Drilling and Remarks:

Line 2913

5" @ 2945

4000 acil

Pump 121 Hk.

RECORD

Cased _____ in., _____ ft.

Sand _____

Gas _____

Oil _____

Total Depth 2955

PRODUCTION

1st 24 hrs. Nat. _____

1st 24 hrs. after shot _____

Gas _____ Cu. Ft.

Dry Hole _____

Abandoned _____

Date

APR 24 1940 19

S. J. LEWIS

Scout