

KANSAS

Form 51-5M-7-40-Palace

Russell


Section 19 Township 14 Range 13-W

Well No. #3 Ehrlich

Company Coralena

NORTH Hall Pool

16

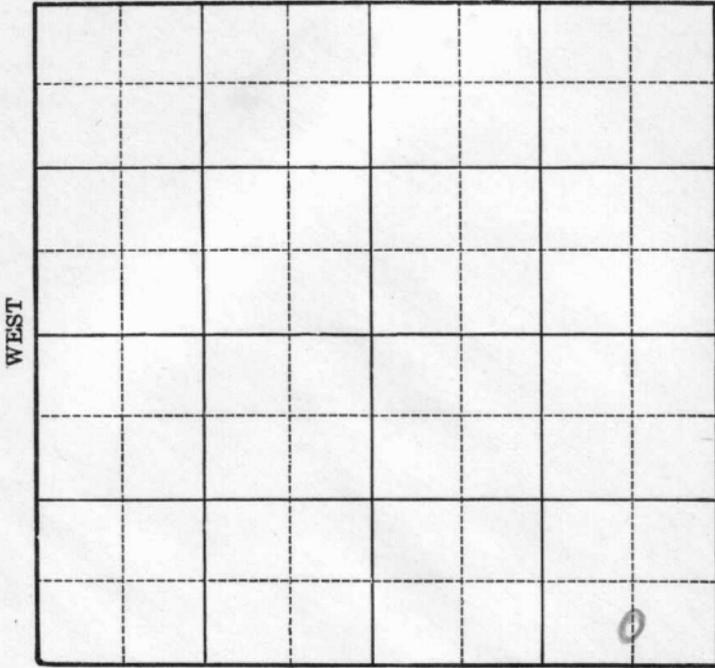

SOUTH

Sec. 19 Twp. 14 R. 13 -W

Well No. #3 Ehrlich Farm

Coralena Company

(Hall)


_____ Ft. from N. Line

330 Ft. from S. Line

660 Ft. from E. Line

_____ Ft. from W. Line

Elev. 1774

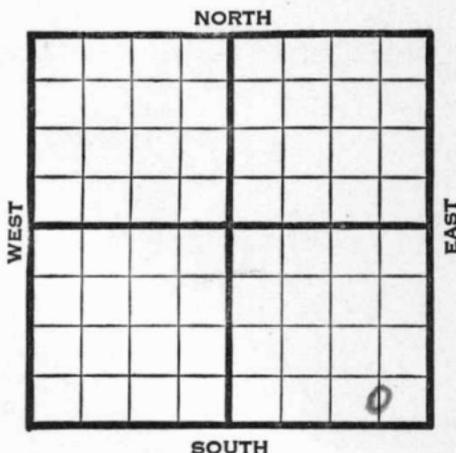

1940	REPORT
9/18	Cellar.
9/26	10" - 230' Drlg. 600'
10/3	Anhy 720' Topeka 2655'
	Lans. 2906' ^{2906'} T.D. 2908' Run 7".
10/10	Lans. 2906' (Corrected)
	7" - 2908' T.D. 2931'
	2000 acid. Testing.
10/17	Lost some tubing in hole.
	Drilling it up.
10/24	Sat. 2935-42' T.D. 2942'
	Swab 21 bbls. per hour after
	head. Will acidize.
10/30	Lans. 2906'
	7" - 2908'
	T.D. 2942'
	4000 acid.
	Potential 2569 bbls., pump.
	COMPLETED

Map No. 72 Sec. 19 Twp. 14 R. 13W

Well No. 3 Ehrlich

Coralena Company

Contractor

FIRST REPORT

SECTION PLAT

C S L SE SE

_____ Ft. from N. Line

330 Ft. from S. Line

660 Ft. from E. Line

_____ Ft. from W. Line

			o

HALL POOL

Location _____

Rig up _____

Drilling and Remarks:

Cellar

RECORD

Cased _____ in., _____ ft.

Sand _____

Gas _____

Oil _____

Total Depth _____

PRODUCTION

1st 24 hrs. Nat. _____

1st 24 hrs. after shot _____

Gas _____ Cu. Ft.

Dry Hole _____

Abandoned _____

Date

SEP 18 1940

19

S. J. LEWIS

Scout

Map No. 72 Sec. 19 Twp. 14 R. 13W

Well No. 3 Ehrlich

Coralena Company

Contractor

COMPLETED

SECTION PLAT

C S L SE SE

 Ft. from N. Line

330 Ft. from S. Line

660 Ft. from E. Line

 Ft. from W. Line

HALL POOL

Location

Rig up

Drilling and Remarks:

Lease 2906

7" @ 2908.

4000 acid

Pump 2569 P.X.

RECORD

Cased in., ft.

Sand

Gas

Oil

Total Depth 2942

PRODUCTION

1st 24 hrs. Nat.

1st 24 hrs. after shot

Gas Cu. Ft.

Dry Hole

Abandoned

Date

OCT 30 1940 19

S. J. LEWIS Scout