


Section 19 Township 14 Range 13-W

Well No. #4 Ehrlich

Company Coralena

Hall Gurney Pool

NORTH

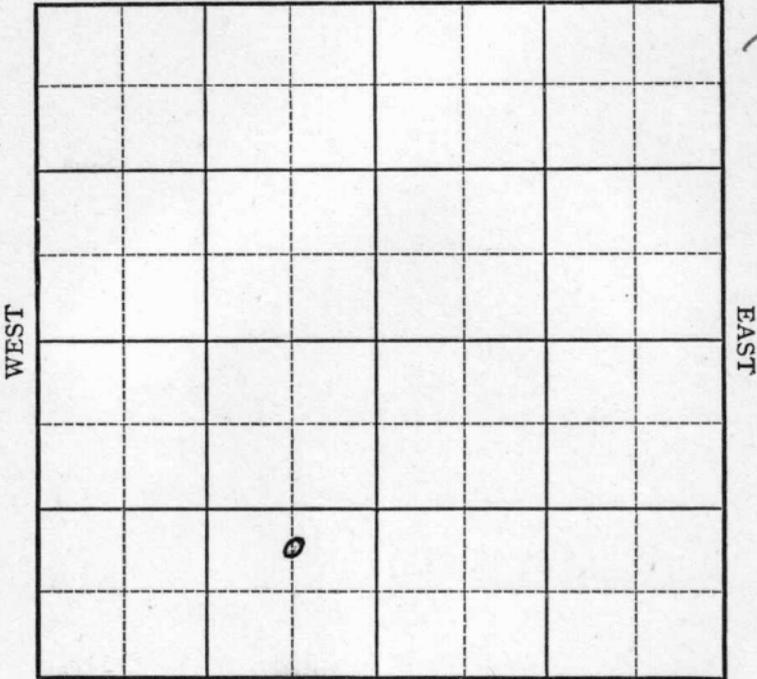

SOUTH

Sec. 19 Twp. 14 R. 13-W

Well No. #4 Ehrlich Farm

Coralena Company


(Hall Gurney)

\_\_\_\_\_ Ft. from N. Line

990 Ft. from S. Line

660 Ft. from E. Line

\_\_\_\_\_ Ft. from W. Line

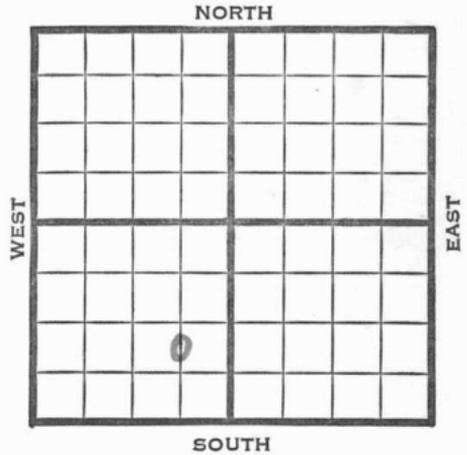

Elev. 1771

194

REPORT

4/30

10" - 240'

Drl g. 500'

5/8

Topeka 2663' Drl g. 2976'

5/15

Lans. 2906' 5 1/2" - 2936'

T.D. 2937' RUST.

5/22

3000 acid. Testing.

5/28

" " "

6/4

Lans. 2906'

5" - 2936'

T.D. 2937'

3000 acid.

Potential 150 bbls., pump.

38.3 Gravity

COMPLETED

Map No. 72 Sec. 19 Twp. 14 R. 13W

Well No. 4 Ehrlich

Coralena Company

Contractor

### FIRST REPORT

### SECTION PLAT

C N L SE SW

\_\_\_\_\_ Ft. from N. Line

990 Ft. from S. Line

660 Ft. from E. Line

\_\_\_\_\_ Ft. from W. Line

	o		

HALL GURNEY POOL

Location \_\_\_\_\_

Rig up \_\_\_\_\_

Drilling and Remarks:

10" - 240

Drlg. 500

### RECORD

Cased \_\_\_\_\_ in., \_\_\_\_\_ ft.

Sand \_\_\_\_\_

Gas \_\_\_\_\_

Oil \_\_\_\_\_

Total Depth \_\_\_\_\_

### PRODUCTION

1st 24 hrs. Nat. \_\_\_\_\_

1st 24 hrs. after shot \_\_\_\_\_

Gas \_\_\_\_\_ Cu. Ft.

Dry Hole \_\_\_\_\_

Abandoned \_\_\_\_\_

Date

APR 30 1941 19

S. J. LEWIS Scout

Map No. \_\_\_\_\_ Sec. 19 Twp. 14 R. 13W

Well No. 4 Ehrlich

Coralena

Company

Contractor

**COMPLETED**

**SECTION PLAT**

C N L SE SW


\_\_\_\_\_ Ft. from N. Line

990 Ft. from S. Line

660 Ft. from E. Line

\_\_\_\_\_ Ft. from W. Line

HALL GURNEY POOL

Location \_\_\_\_\_

**RECORD**

Cased \_\_\_\_\_ in., \_\_\_\_\_ ft.

Sand \_\_\_\_\_

Gas \_\_\_\_\_

Oil \_\_\_\_\_

Total Depth 2937

Rig up \_\_\_\_\_

Drilling and Remarks:

*Lane 2906*  
*5" C 2936*  
*3000 acid*  
*Pump 150 P.A.*  
  
*38<sup>3</sup> G*

**PRODUCTION**

1st 24 hrs. Nat. \_\_\_\_\_

1st 24 hrs. after shot \_\_\_\_\_

Gas \_\_\_\_\_ Cu. Ft.

Dry Hole \_\_\_\_\_

Abandoned \_\_\_\_\_

Date

JUN 4 1941 19 \_\_\_\_\_

S. J. LEWIS Scout