


SEC. 11	TWP. 15	R. 14W
------------	------------	-----------

WELL NO. #17 Flegler "B" FARM

COMPANY N C R A

CONTRACTOR

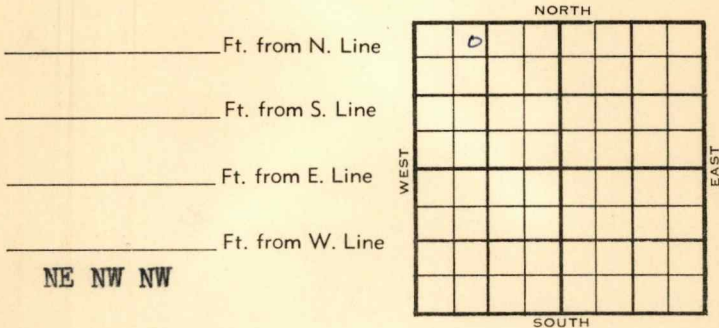

1955	ELEVATION 1718	REPORT
------	-------------------	--------

9-14 Location

11/9 Comm 10-10-55
 8 5/8" @ 746/425
 Anh 733
 Tarkio 2296
 H 2852
 Tr 2867
 L 2915
 A 3199
 TD 3203
 DST 2870-90 open 1 hr rec 25' socm
 150/30" DST 3196-3203 open 1 hr
 rec 55' wml 950/30" 5 1/2" @ 2930
 CO to 2903 24/2869-73 B/2 go
 12% wtr 6 hr S/10 bo 6% wtr 3hr
 Comp 45 bopd 4 1/2 bw

COMPLETED

County Russell Elev. _____
 Sec. 11 Twp. 15 Rge. 14W
 Company NCRA
 Farm Name Flegler "B" No. 17

Co.
Lse.
No.
Sec.
T.
R.

TOPS	DEPTH	LOG	DATUM
Anh.			
TP.			
H.			
Tr.			
Dg.			
Bl.			
L.			
K.C.			
B.K.C.			
Ce.			
C.			
M.			
M.			
K.			
Mz.			
Mq.			
V.			
S.			
S.			
A.			
R.			
PE.			
G.			
T.D.			

Loc. in Sec. NE NW NW

Geol. _____

Contr. _____

Pool _____

0	
SEP 14 '55	
FIRST REPORT	

Date Comm. _____
 Location _____

[Handwritten signature]

County Russell Elev. 1718
 Sec. 11 Twp. 15 Rge. 14W
 Company N C R A
 Farm Name Flegler "B" No. 17

TOPS	DEPTH	LOG	DATUM
Anh.	<u>233</u>		
Tp. <u>Jarkis</u>	<u>2396</u>		<u>578</u>
H.	<u>2852</u>		<u>1134</u>
Tr.	<u>2867</u>		<u>1149</u>
Dg.			
Bl.			
L.	<u>2915</u>		<u>1197</u>
K.C.			
B.K.C.			
Ce.			
C.			
M.			
M.			
K.			
Mz.			
Me.			
V.			
S.			
S.			
A	<u>3199</u>		<u>1481</u>
R.			
PE.			
G.			
T.D.	<u>3203</u>		

Loc. in Sec. NE NW NW
 Geol. _____
 Contr. _____
 Pool _____

0		
COMPLETE		

Date Comm. 10-10-55 NOV 9 1955
8 5/8" @ 746/425 DST 2870-90 open
1 hr. rec. 25' socm 150/30"
DST 3196-3203 open 1 hr. rec. 55' wnm
950/30" 5 1/2" @ 2930 CO to 2903
24/ 2869-73 B/ 2 go 12 gw 14 hr.
3000 A S/ 23 bf 12% wtr. 6 hr.
S/ 10 bo 6% wtr. 3 hr.
Comp. 45 bopd 4 1/2 bw

Co. Lse. No. Sec. T. R.