


Section 15 Township 14 Range 13W

Well No. #2 Dumler

Company Duke & Wood

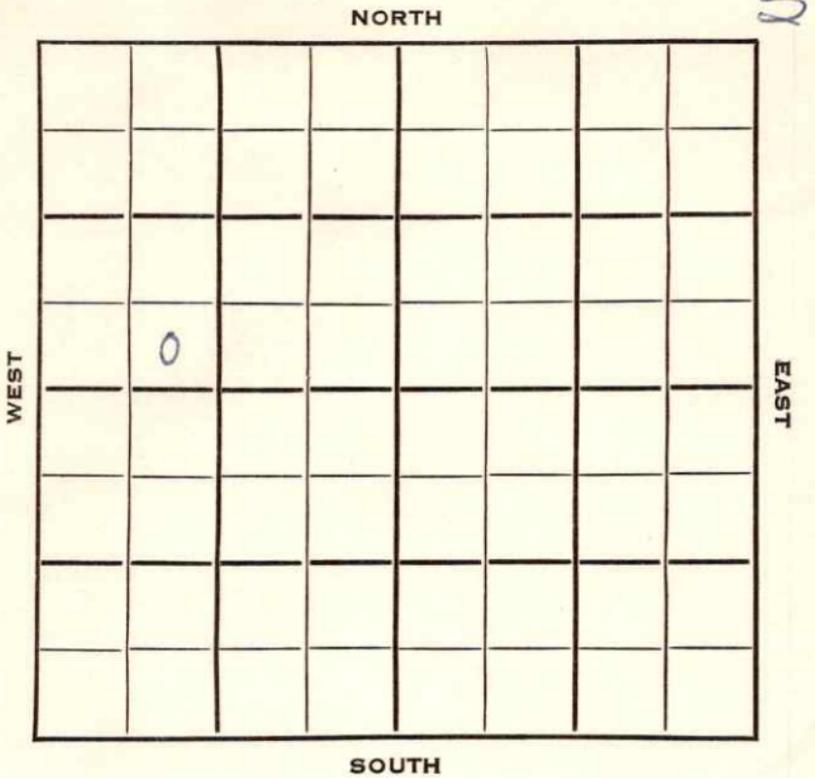

Russell

KANSAS

SEC.	TWP.	R.
15	14	13W


WELL NO. #2 Dumler FARM

COMPANY Duke & Wood

CONTRACTOR Duke & Wood

Hall-Gurney Pool

_____ Ft. from N. Line
 330 _____ Ft. from S. Line
 _____ Ft. from E. Line
 990 _____ Ft. from W. Line

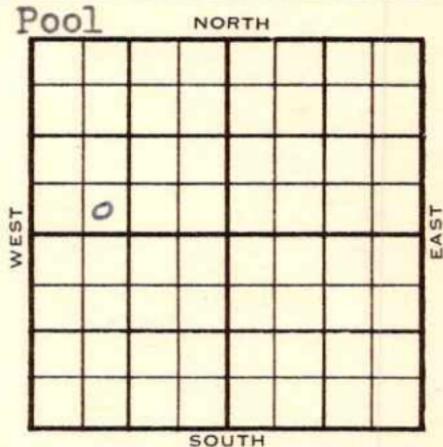

SE SW NW

	ELEVATION	REPORT
--	-----------	--------

1953

1774'

REPORT

- 11/11 Cellar & Pits
- 11/18 8" @ 234' Anhy 717'
Drlg. 1925'
- 12/22 Spud 11-12-53
Oil Well
TD 2345'
8" @ 234'
Anhy 717', Tarkio 2306'
TD 2345'
5" @ 2345'
CO to 2338'
35/2309-13, 2-3/4 goph
Sd-oil-frac, 4 boph
Comp. 25 bopd

COMPLETED

